

Section 23 Township 19 Range 12 W

Well No. # 9 Lanterman (A)

Company Hannum Drlg.

NORTH

m

		0					

SOUTH

WEST

EAST

Barton

KANSAS

Sec. 23 Twp. 19 R. 12 W

Well No. # 9 Lanterman (A) Farm

Hannum Drlg. Company

Contractor

Hammer Pool


330 Ft. from N. Line

 Ft. from S. Line

990 Ft. from E. Line

 Ft. from W. Line

NW NE NW

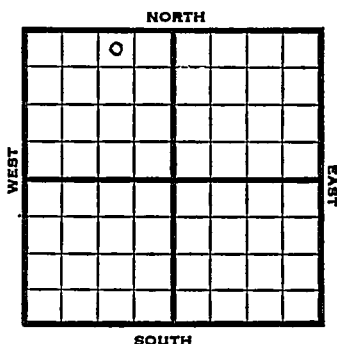

1951 Elev. 1849' REPORT

6/27 Spud 6-22-51
8" @ 265 Anhy 655'
Drlg. 1850'

8/15 Spud 6-22-51
Oil well TD 3450' 8" @ 265
Anhy 655' Heeb 3015' Br. lime 3130'
Lans. 1342'
DST 3144-3218' open $\frac{1}{2}$ hr. rec 60' GCM
300' HOCM
Cong. 3402' Arb. 3437' 5" @ 3437
TD 3450' 250 A Rec 10 BO
PB 3355' 47/3178-94 1000 A
S/10 BO PB 3177 6/3164-66
16/3161-67 18/3150-54 1000 A
S/40 BOPH CO to 3355'
Comp. 267 BOPD

COMPLETED

County Barton State Kansas
 Sec. 25 (Blk.) 19 (Sur.) 12W Map No.
 Operator Hammer Drig.
 Well No. 9 Farm Lenterman (A)
 Elev. _____ Location NW NE NW

330 Ft. From N Line NW
990 Ft. From E Line Quarter

1st. Report JUN 27 1951

Completion _____

Remarks _____

Spudding Date 6-22-51

Drig. Data Hammer Pool
8" @ 265 anhy. 655' Drig. 1850

J. E. TYRA

County Barton State KansasSec. 23 (Blk.
Twp.) 19 (Sur.
Rge.) 12W Map No.Operator Hannum Drlg.Well No. 9 Farm Lanterman "A"Elev. 1849 Location NW NE NW

		0					

COMPLETE330 Ft. From N Line NW990 Ft. From E Line Quarter

1st. Report

Completion AUG 15 1951Remarks Hammer PoolSpudding Date 6-22-51Drlg. Data Oil well TD 34508" @ 265 Anhy 655 Heeb. 3015Br. lime 3130 Lans. 1342 DST 3144-3218open $\frac{1}{2}$ hr. Rec. 60' gcm 300' hocomCong. 3402 Arb. 3437 5" @ 3437 TD 3450250 A Rec. 10 bo PB 3355 47/ 3178-941000 A S/ 10 bo PB 3177 6/ 3164-6616/ 3161-67 18/ 3150-54 1000 AS/ 40 boph CO to 3355 Comp. 267 bopd

J. E. TYRA