

Section 23 Township 19 Range 12W

Well No. #7 Lanterman

Company Hannum Drlg.

NORTH

6

			o				

WEST

EAST

SOUTH

Sec. 23 Twp. 19 R. 12W ✓

Well No. #7 Lanterman Farm

Hannum Drllg. Company

Contractor

Hammer, North


           Ft. from N. Line

990' Ft. from S. Line

330' Ft. from E. Line

           Ft. from W. Line

NE SE NW

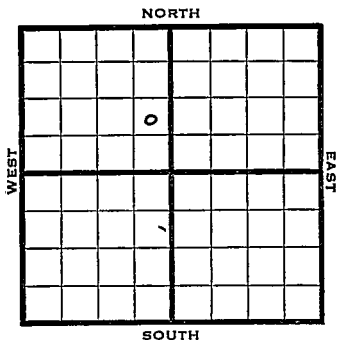

1960

Elev. 1825' REPORT

4/19 Location

5/31 8" @ 233'  
Anhy 650'  
KC 3110  
Cong. 3387'  
Arb. 3408'  
5" @ 3500  
TD 3660'  
24/3405-12 SQ  
250 A  
Comp. 50 BOPD

**COMPLETED**

Map No. \_\_\_\_\_ Sec. 23 Twp. 19 R. 12W

Well No. 7 Lanterman

Hannum Drlg. Company

Contractor

NE SE NW

**SECTION PLAT**

	o		
FIRST REPORT			

\_\_\_\_\_ Ft. from N. Line

990 Ft. from S. Line

330 Ft. from E. Line

\_\_\_\_\_ Ft. from W. Line

Barton County

Location X

Rig up \_\_\_\_\_

Drilling and Remarks:

**RECORD**

Cased \_\_\_\_\_ in., \_\_\_\_\_ ft.

Sand \_\_\_\_\_

Gas \_\_\_\_\_

Oil \_\_\_\_\_

Total Depth \_\_\_\_\_

**PRODUCTION**

1st 24 hrs. Nat. \_\_\_\_\_

1st 24 hrs. after shot \_\_\_\_\_

Gas \_\_\_\_\_ Cu. Ft.

Dry Hole \_\_\_\_\_

Abandoned \_\_\_\_\_

Date

APR 19 1950

J. E. TYRA Scout



Map No. \_\_\_\_\_ Sec. 23 \_\_\_\_\_ Twp. 19 \_\_\_\_\_ R. 12W \_\_\_\_\_

Well No. 7 Lanterman

Hannum Drlg. \_\_\_\_\_ Company

Contractor

NE SE NW

E1.1825  
SECTION PLAT

\_\_\_\_\_ Ft. from N. Line

990 Ft. from S. Line

330 Ft. from E. Line

\_\_\_\_\_ Ft. from W. Line

	0		
	COMPLETE		

Bartpn

Location \_\_\_\_\_

Rig up \_\_\_\_\_

Drilling and Remarks:

8" c 233  
anhy 650  
KC. 3110  
Comp. 3387  
arbl. 3408  
5" c 3500  
T.D. 3660

RECORD

Cased \_\_\_\_\_ in., \_\_\_\_\_ ft.

Sand \_\_\_\_\_

Gas \_\_\_\_\_

Oil \_\_\_\_\_

Total Depth \_\_\_\_\_

PRODUCTION

1st 24 hrs. Nat. \_\_\_\_\_

1st 24 hrs. after shot \_\_\_\_\_

Gas \_\_\_\_\_ Cu. Ft.

Dry Hole \_\_\_\_\_

Abandoned \_\_\_\_\_


Date

MAY 31 1950

19

J. F. TYRA Scout

Scout Cards  
Land Small Map  
Land Wall Map  
Tracings  
France Map  
Pierce Map  
Misc.

 

Scout Cards  
Land Small Map  
Land Wall Map  
Tracings  
France Map  
Pierce Map  
Misc.

RECORD

Scout Cards	.....
Land Small Map	.....
Land Wall Map	.....
Tracings	.....
France Map	.....
Pierce Map	.....
Misc.	.....

24/3405-12 20  
250 A  
Camp 50 kept