

Section 23 Township 19 Range 12W

Well No. #11 Lanterman "A"

Company Geo Hannum

NORTH

2

	○						

WEST

EAST

SOUTH

Sec. 23 Twp. 19 R. 12W

Well No. #11 Lanterman "A" Farm

Geo. Hannum Company

Hammer Contractor


330' Ft. from N. Line

..... Ft. from S. Line

..... Ft. from E. Line

990' Ft. from W. Line

NE NW NW

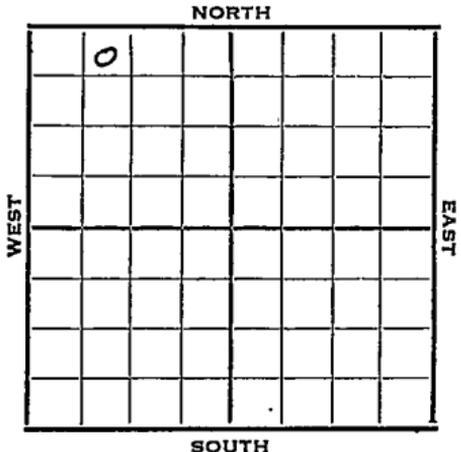

1951 Elev. 1848' REPORT

11/28 Location

1952
1/9

Spud 11-27-51
 Oil Well TD 3430
 8" @ 265
 Anhy 638
 Heeb. 3013
 Br lime 3127
 KC 3141
 DST 3143-3207 opn 1 hr. gas in 15 min. Rec. 360' o & gcm
 DST 3281-3336 opn 1 hr Rec. 1980' ga 90' o& gcm 150' ho & gcm
 Cong. 3406 Arb. 3414-21
 5" @ 3418 TD 3430 500 A
 PB 3210 9/3166-69
 6/3160-66 1000 A S/3 boph
 Comp. 130 bopd

COMPLETED

County Barton State Kansas

Sec. 23 (Blk. 19) (Sur. 1 2W) Twp. (Rge.) Map No.

Operator Geo. Hannum

Well No. 11 Farm Lanternman "A"

Elev. 1848 Location NE NW NW

0					

330 Ft. From N Line NW

990 Ft. From W Line Quarter

Ist. Report

Completion JAN 9 1952

Remarks Hammer Pool

Spudding Date 11-27-51

Drlg. Data Oil well TD 3430

8" @ 265 Anhy 638 Heeb. 3013

Br. lime 3127 KC 3141 DST 3143-3207

open 1 hr. gas in 15 min. Rec. 360'

o & gcm DST 3281-3336 open 1 hr.

Rec. 1980' gas 90' o & gcm 150' ho & gcm

Cong. 3406 Arb. 3414-21 5" @ 3418

TD 3430 500' A PB 3210 9/ 3166-69

6/ 3160-66 1000 A S/ 3 bopd

Comp. 130 bopd

J. E. TYRA

