

Section 23 Township 19N Range 12W

Well No. 3 Wagner

Company Aladdin Pet

Hammer  
NORTH

WEST

EAST

|  |   |  |   |  |  |  |  |
|--|---|--|---|--|--|--|--|
|  |   |  |   |  |  |  |  |
|  |   |  |   |  |  |  |  |
|  |   |  | 6 |  |  |  |  |
|  | 1 |  |   |  |  |  |  |
|  |   |  |   |  |  |  |  |
|  |   |  |   |  |  |  |  |

SOUTH

**KANSAS**

Barton

Sec. 23 Twp. 19 R. 12W ✓

Well No. #3 Wagner Farm

Aladdin Pet. Company

Hammer Pool


990' Ft. from N. Line

Ft. from S. Line

330' Ft. from E. Line

Ft. from W. Line

SE NE SW

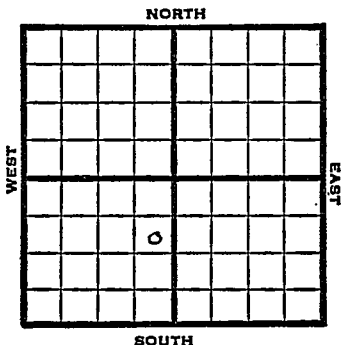

1949

Elev 1814'

REPORT

5/11

8" @ 226'

5/18

Lansing 3104'  
D rlg 3195'

5/25

Arb 3362-64'  
TD 3364'

5" @ 3363'

6/1

TD 3364'  
Lans. 3104'  
5 @ 3363'  
Perf  
2000 acid  
Pump 1064 Oil Pot  
41° Gr.  
Comp

**COMPLETED**

Map No. \_\_\_\_\_ Sec. 23 Twp. 19 R. 12WWell No. 3 Wagner

\_\_\_\_\_ Aladdin Pet. \_\_\_\_\_ Company

Hannum

Contractor

SE NE SW

FIRST REPORT  
SECTION PLAT990 Ft. from N. Line

\_\_\_\_\_ Ft. from S. Line

330 Ft. from E. Line

\_\_\_\_\_ Ft. from W. Line

|  |  |  |  |
|--|--|--|--|
|  |  |  |  |
|  |  |  |  |
|  |  |  |  |
|  |  |  |  |

Barton County

Location \_\_\_\_\_

Rig up \_\_\_\_\_

Drilling and Remarks:

8" @ 226

## RECORD

Cased \_\_\_\_\_ in., \_\_\_\_\_ ft.

Sand \_\_\_\_\_

Gas \_\_\_\_\_

Oil \_\_\_\_\_

Total Depth \_\_\_\_\_

## . PRODUCTION

1st 24 hrs. Nat. \_\_\_\_\_

1st 24 hrs. after shot \_\_\_\_\_

Gas \_\_\_\_\_ Cu. Ft.

Dry Hole \_\_\_\_\_

Abandoned \_\_\_\_\_

Date

MAY 11 1949 19

S. J. LEWIS Scout

Map No. K44 Sec. 23 Twp. 19 R. 12W

Well No. 3 Wagner

Aladdin Pet. Company

**COMPLETE**

Contractor

SE NE SW

B. 11874

**SECTION PLAT**

990 Ft. from N. Line

       Ft. from S. Line

330 Ft. from E. Line

       Ft. from W. Line

|  |  |  |  |
|--|--|--|--|
|  |  |  |  |
|  |  |  |  |
|  |  |  |  |
|  |  |  |  |

Barton County

**RECORD**

Location       

Cased        in.,        ft.

Rig up       

Sand       

Drilling and Remarks:

Gas       

Oil       

Total Depth 2364

Lions 3184

5-C 3363

**PRODUCTION**

1st 24 hrs. Nat.       

1st 24 hrs. after shot       

Gas        Cu. Ft.

Dry Hole       

Abandoned       

Prof 4  
2000 acid

Prod 1064 oil Box

412 Lb

Date

JUN 1 1949 19

S. J. LEWIS

Scout