


Section 23 Township 19 Range 10 W

Well No. #3 Dipple

Company Bay Pet.

Silica Pool

NORTH

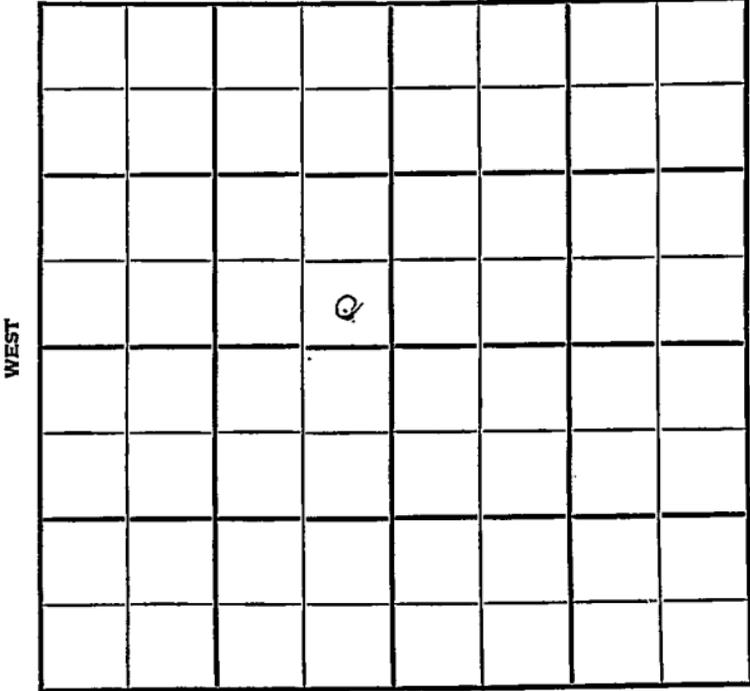

SOUTH




Sec. 23 Twp. 19 R. 10W

Well No. #3 Dipple Farm  
Bay Pet. Company

Silica Pool

         Ft. from N. Line  
330' Ft. from S. Line  
330' Ft. from E. Line  
         Ft. from W. Line  
SE NW

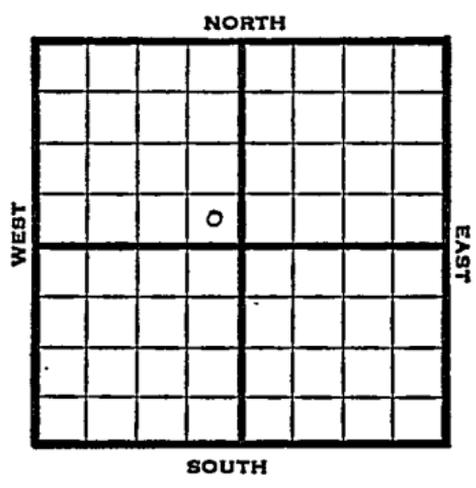

1948

Elev. 1741' REPORT

5/26

8" @ 214'  
Drlg. 1500'

6/1

Lansing 2928'  
Drlg. 3030'

6/9

Arb. 3260'  
TD 3263'  
Run 5"

6/16

5" @ 3260'  
TD 3265'  
500 acid  
2200' oil 10 hrs.

6/23

"

6/30

Arbuckle 3260'  
5" @ 3260'  
Pump 90 Pot. Oil  
Gr. 42°  
TD 3265'

**COMPLETED**

Map No. \_\_\_\_\_ Sec. 23 Twp. 19 R. 10W

Well No. 3 Dipple

Bay Pet. Company

FIRST REPORT Contractor

SE NW

SECTION PLAT

\_\_\_\_\_ Ft. from N. Line

330 Ft. from S. Line

330 Ft. from E. Line

\_\_\_\_\_ Ft. from W. Line

		o	

Rice County

Location \_\_\_\_\_

Rig up \_\_\_\_\_

Drilling and Remarks:

.8" @ 214

drlg. 1500

RECORD

Cased \_\_\_\_\_ in., \_\_\_\_\_ ft.

Sand \_\_\_\_\_

Gas \_\_\_\_\_

Oil \_\_\_\_\_

Total Depth \_\_\_\_\_

PRODUCTION

1st 24 hrs. Nat. \_\_\_\_\_

1st 24 hrs. after shot \_\_\_\_\_

Gas \_\_\_\_\_ Cu. Ft.

Dry Hole \_\_\_\_\_

Abandoned \_\_\_\_\_

Date

MAY 26 1948 19

S. J. LEWIS Scout

Map No. 46 Sec. 23 Twp. 19 R. 10W

Well No. 3 Dipple

Bay Pet. Company

**COMPLETE**

Contractor

SE NW

E. 1741

SECTION PLAT

         Ft. from N. Line

330 Ft. from S. Line

330 Ft. from E. Line

         Ft. from W. Line


Rice County

RECORD

Location         

Cased          in.,          ft.

Rig up         

Sand         

Drilling and Remarks:

Gas         

Oil          

Total Depth 3265

Cor 73260  
5" @ 3260  
Pump 90 Prod  
42 2/3

PRODUCTION

1st 24 hrs. Nat.         

1st 24 hrs. after shot         

Gas          Cu. Ft.

Dry Hole         

Abandoned         

Date

JUN 30 1948 19

S. J. LEWIS Scout