

KANSAS

Rice


Section 23 Township 19 Range 10WWell No. 5 DippelCompany Chalmette et al

Silica Pool

NORTH

WEST

EAST

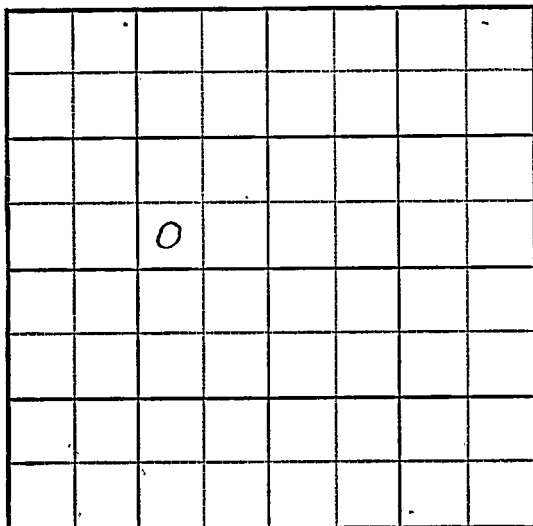


SOUTH

KANSAS RiceSec. 23 Twp. 19 R. 10W ✓Well No. #5 Dippol FarmChalmette et al Company**Silica Pool**

Ft. from N. Line

330' Ft. from S. Line990' Ft. from E. Line

Ft. from W. Line

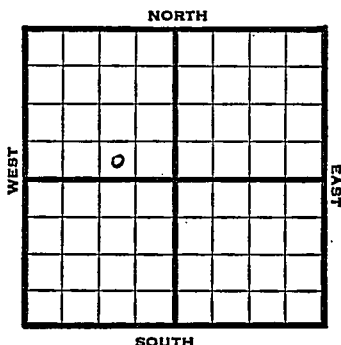SW SE NW**1948** **Eli 1741'** **REPORT**

9/15 Location

9/21 "

9/29 "

10/6 8" @ 215'
Drlg 2550'

10/13 Lansing 2925'
Arb. 3280'
TD 2980'
5" @ 3278'

10/19 PB 3198'
48 shots 3151-59 500 Acid
Swb 50 bbls oil / 10 W 12 hrs.
36 shots 3134-39 500 Acid

10/27 TD 3280'
Arb. 3280'
5" @ 3278'
Lans. 2925'
Perf Lans 500 acid
Pump 50 oil Pot
42° Gr.
Comp

COMPLETED

Rice County Kansas State

Map No. _____ Sec. 23 Twp. 19 R. 10W

Well No. 5 Dippel

Chalmette etal. Company

FIRST REPORT

Contractor

SW SE NW

SECTION PLAT

_____ Ft. from N. Line

330 Ft. from S. Line

990 Ft. from E. Line

_____ Ft. from W. Line

Silica Pool

Remarks:

Location

Date

SEP 15 1948

Scout

S. J. LEWIS

Map No. 46 Sec. 23 Twp. 19 R. 10W

Well No. 5 Dippel

Chalmette et al. Company

COMPLETE

Contractor

SW SE NW

E11741
SECTION PLAT

 Ft. from N. Line

330 Ft. from S. Line

990 Ft. from E. Line

 Ft. from W. Line

Rice County

Location

Rig up

Drilling and Remarks:

On 83280

5" @ 3278

have 2925

Perf have
500000

Proved oil

42.9 ft

RECORD

Cased in., ft.

Sand

Gas

Oil

Total Depth 3280

PRODUCTION

1st 24 hrs. Nat.

1st 24 hrs. after shot

Gas Cu. Ft.

Dry Hole

Abandoned

Date

OCT 27 1948 19

S. J. LEWIS Scout