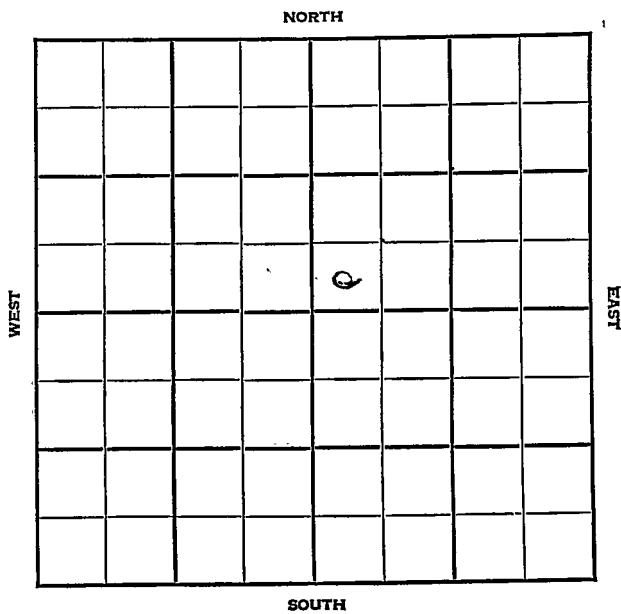


KANSAS Rice

Section 23 Township 19 Range 10WWell No. #1 Dippel "B"Company Lowell - Woltz

Rice

KANSAS

Sec. 23 Twp. 19 R. 10W

Well No. #1 Dippel "B" Farm

Lowell-Woltz Company

Silica Pool


 Ft. from N. Line

330' Ft. from S. Line

 Ft. from E. Line

330' Ft. from W. Line

SW NE

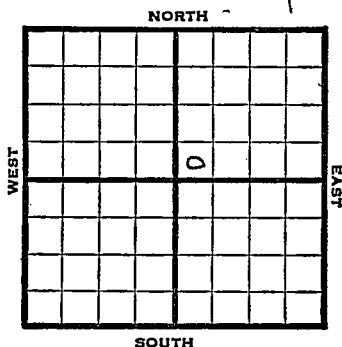

1948

Elev. 1739' REPORT

2/4 8" @ 205'
Lans. 2932'
Drlg. 3116'

2/11 Arbuckle 3250'
TD 3252'
4" @ 3252'
RUST

2/18 Arb. 3250'
4" @ 3252'
Pump 160 Pot
42.4 Gr.
TD 3267'
Comp.

COMPLETED

Map No. _____ Sec. 23 Twp. 19 R. 10W

Well No. 1 Dippel "B"

Lowell - Woltz Company

FIRST REPORT

Contractor

SW NE


SECTION PLAT

_____ Ft. from N. Line

330 Ft. from S. Line

_____ Ft. from E. Line

330 Ft. from W. Line

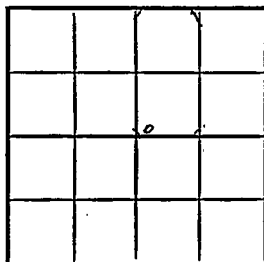

Rice County

Location _____

Rig up _____

Drilling and Remarks: +

8" @ 205

Lans. 2932

drlg. 3116

RECORD

Cased _____ in., _____ ft.

Sand _____

Gas _____

Oil _____

Total Depth _____

PRODUCTION

1st 24 hrs. Nat. _____

1st 24 hrs. after shot _____

Gas _____ Cu. Ft.

Dry Hole _____

Abandoned _____

Date

FEB 4 1948 19

S I I FWIS Scout

Kansas


Map No. 46 Sec. 23 Twp. 19 R. 10WWell No. 1 Dippel "B"Lowell - Woltz

Company

COMPLETE

Contractor

SW NE

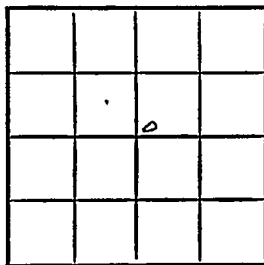E1, 1787
SECTION PLAT Ft. from N. Line330 Ft. from S. Line Ft. from E. Line330 Ft. from W. LineRice CountyLocation Rig up

Drilling and Remarks:

Cor 82504' 8252Pump 160 RY42 1/2**RECORD**Cased in., ft.Sand Gas Oil ✓Total Depth 0267**PRODUCTION**1st 24 hrs. Nat. 1st 24 hrs. after shot Gas Cu. Ft.Dry Hole Abandoned

Date

FEB 18 194619S. J. LEWIS

Scout