

Section 23 Township 19 Range 10W

Well No. 2 Stroh

Company Woodriver Oil & Ref.

Silica

NORTH

WEST

EAST

SOUTH

KANSAS

Rice



Sec. 23 Twp. 19 R. 10W

Well No. #2 Stroh Farm

Woodriver Oil & Ref. Company


Silica Pool

_____ Ft. from N. Line

990' Ft. from S. Line

_____ Ft. from E. Line

330' Ft. from W. Line

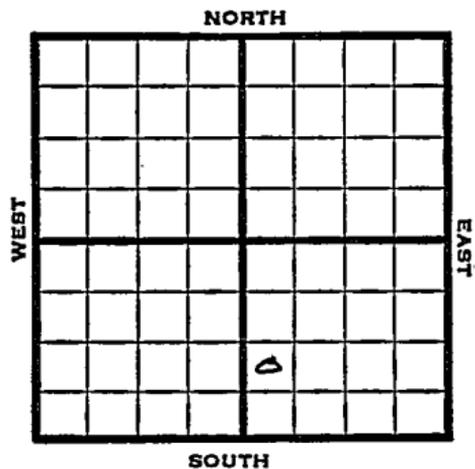

NW SW SE

1949 Elev. 1747' REPORT

- 4/27 8" @ 235'
- Anhy 400'
- Drlg. 1503'
- 5/4 Lansing 3943'
- Simp 3260'
- Arb. 3266-68'
- TD 3268'
- 5" @ 3267'
- 5/10 "
- 5/18 TD 3277
- 2400 acid
- Swb 40 bbls oil PH 24 hrs.
- 5/25 "
- 6/1 "
- 6/7 "
- 6/15 "
- 6/22 Arb 3266'
- 5" @ 3267'
- Acid 2400
- Pump 30 oil Pot.
- Gr. 42°
- TD 3277'

COMPLETED

Map No. _____ Sec. 23 Twp. 19 R. 10W

Well No. 2 Stroh

Woodriver Oil & Ref. Company

FIRST REPORT Contractor

NW SW SE

SECTION FLAT

_____ Ft. from N. Line

990 Ft. from S. Line

_____ Ft. from E. Line

330 Ft. from W. Line

		o	

Rice County

Location _____

Rig up _____

Drilling and Remarks:

8" @ 235
Anhy 400
drlg. 1503

RECORD

Cased _____ in., _____ ft.

Sand _____

Gas _____

Oil _____

Total Depth _____

PRODUCTION

1st 24 hrs. Nat. _____

1st 24 hrs. after shot _____

Gas _____ Cu. Ft.

Dry Hole _____

Abandoned _____

Date

APR 27 1949 19

S. J. LEWIS Scout

