

KANSAS Rice

Section 23 Township 19 Range 10W

Well No. 5 Bernstorff "B"

Company Skelly

Silica

NORTH

			0				

WEST

EAST

SOUTH

Sec. 23 Twp. 19 R. 10-W ✓

Well No. #5 Bernstorf "B" Farm

Skelly Company

Silica


990 Ft. from N. Line

_____ Ft. from S. Line

330 Ft. from E. Line

_____ Ft. from W. Line

SE NE SW

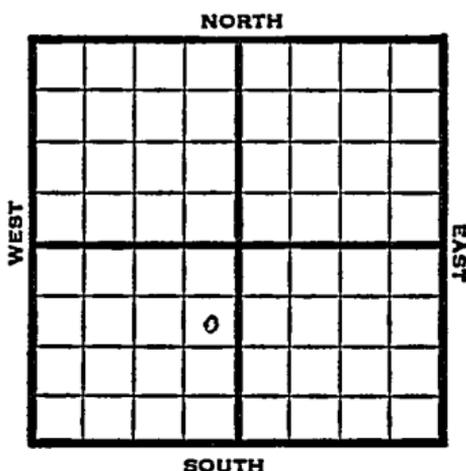

1949 Elev 1745' REPORT

1/26	8" @ 415'
	Drlg 1500
2/2	Lansing 2936'
	Arbuckle 3266'
	TD 3270'
	5" @ 3267'
2/9	"
2/16	TD 3275
	Swb 83 bbls oil 2½ hrs.
2/23	Pump 167 bbl oil 8 hrs.
3/2	TD 3275'
	Arb. 3266'
	5" @ 3267'
	Pump 144 Oil Pot
	42° Gr.
	Comp

COMPLETED

Map No. _____ Sec. 23 Twp. 19 R. 10 ¹⁰ 10

Well No. 5 Bernstorf "B"

Skelly Company

FIRST REPORT Contractor

SE NE SW

SECTION PLAT

990 Ft. from N. Line

_____ Ft. from S. Line

330 Ft. from E. Line

_____ Ft. from W. Line

Rice County

Location _____

Rig up _____

Drilling and Remarks:

8" @ 415

drlg. 1500

RECORD

Cased _____ in., _____ ft.

Sand _____

Gas _____

Oil _____

Total Depth _____

PRODUCTION

1st 24 hrs. Nat. _____

1st 24 hrs. after shot _____

Gas _____ Cu. Ft.

Dry Hole _____

Abandoned _____

Date

JAN 26 1949 19

S. J. LEWIS Scout

Kansas

Map No. K46 Sec. 23 Twp. 19 R. 10WWell No. 5 Bernstorff "B"Skelly Company

COMPLETE

Contractor

SE NE SW

E 1, 12 45
SECTION PLAT990 Ft. from N. Line Ft. from S. Line330 Ft. from E. Line Ft. from W. Line

Rice County

Location Rig up

Drilling and Remarks:

Per 82665" 8267Prod 144 oil42 3/4

RECORD

Cased in., ft.Sand Gas Oil Total Depth 2275

PRODUCTION

1st 24 hrs. Nat. 1st 24 hrs. after shot Gas Cu. Ft.Dry Hole Abandoned

Date

MAR 2 1949 19

S. I. LEWIS Scout