


KANSAS

Rice

Section 23 Township 19 Range 10WWell No. 4 Bernstorff "D"Company Skelly

Silica Pool

NORTH

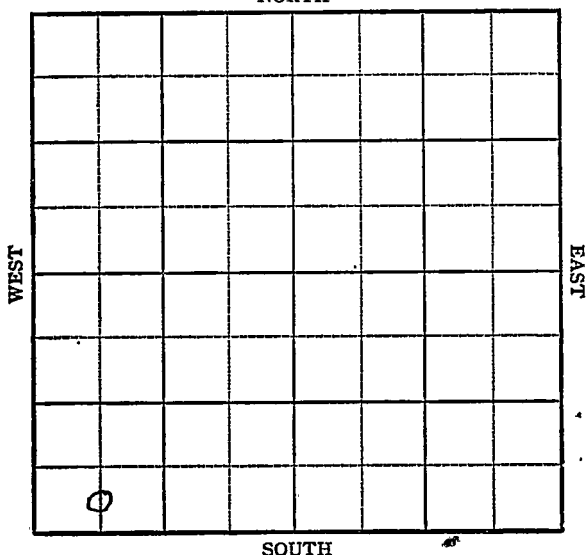



Sec. 23 Twp. 19 R. 10-W

Well No. #4 Bernstorff "D" Farm

Skelly Company

Silica


 Ft. from N. Line

330 Ft. from S. Line

 Ft. from E. Line

660 Ft. from W. Line

C S L SW SW

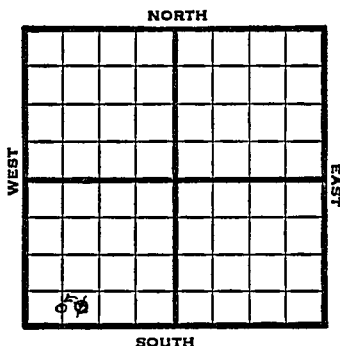

1948

Elev. 1746' REPORT

10/6

Location

10/13

8" @ 431'

Drlg 2420'

10/19

Lans'ng 2948'

Arb. 3293'

TD 3295'

5" @ 3294'

"

10/26

11/3

TD 3296'

PB 3148'

48 shots 3124-37 - 500 acid

Swb 21 bbls W 7 hrs.

11/10

" ;

11/17

Lans. 2948'

Arb. 3293'

5" @ 3294'

Perf Lans.

500 acid

Pump 29 oil & 19 W Pot.

Gr. 42

TD 3296'

COMPLETED

Map No. _____ Sec. 23 Twp. 19 R. 10W

Well No. 4 Bernstorff "D"

Skelly Company

FIRST REPORT Contractor

C S L SW SW

SECTION PLAT

_____ Ft. from N. Line

330 Ft. from S. Line

_____ Ft. from E. Line

660 Ft. from W. Line

Rice County

Location X

Rig up _____

Drilling and Remarks:

RECORD

Cased _____ in., _____ ft.

Sand _____

Gas _____

Oil _____

Total Depth _____

PRODUCTION

1st 24 hrs. Nat. _____

1st 24 hrs. after shot _____

Gas _____ Cu. Ft.

Dry Hole _____

Abandoned _____

Date

OCT 6 1948 19 S. J. LEWIS Scout

Map No. 76 Sec. 23 Twp. 19 R. 10W

Well No. 4 Bernstorff "D"

Skelly Company

COMPLETE

Contractor

C S L SW SW

E11746

SECTION PLAT

 Ft. from N. Line

330 Ft. from S. Line

 Ft. from E. Line

660 Ft. from W. Line

Rice County

Location

Rig up

Drilling and Remarks:

*Loss 2948
C28293
5" C294
Prof. Loss.
5000 cu. ft.
Pump 29 oil + 19 N
P28 42 2 1/2*

RECORD

Cased in., ft.

Sand

Gas

Oil

Total Depth 2296

PRODUCTION

1st 24 hrs. Nat.

1st 24 hrs. after shot

Gas Cu. Ft.

Dry Hole

Abandoned

Date

NOV 17 1948

19

S. J. LEWIS

Scout