

KANSAS


Rice County

FORM 51 5M BR1X

Section 23 Township 19 Range 10W

Well No. 1 ~~Johnson~~ *Dipple*

Company Jack Robertson et al.

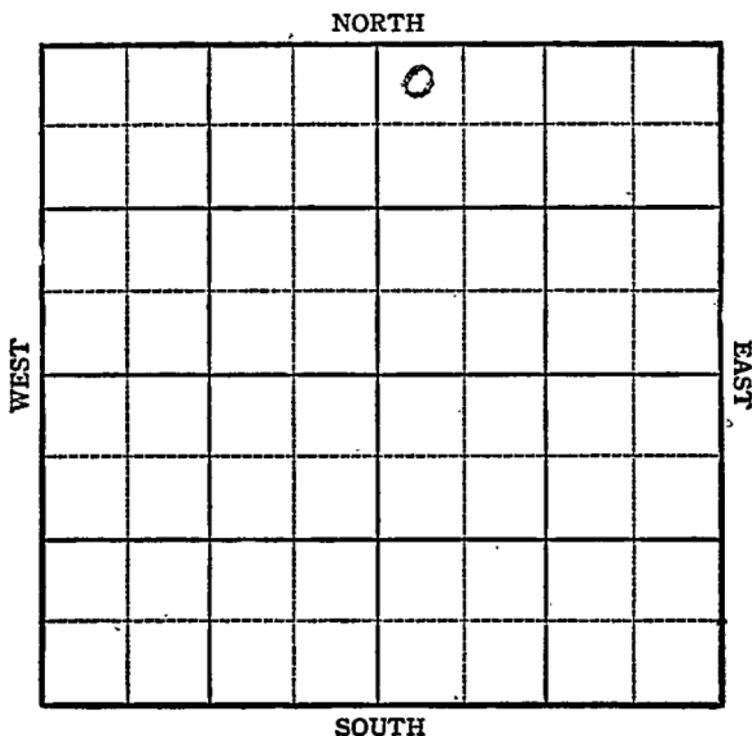

23 **KANSAS**

Rice

19


10W

Sec. _____ Twp. _____ R. _____

Well No. #1 ~~Johnson~~ *Dipple* Farm

Jack Robertson etal Company

Silica
330' Ft. from N. Line
____ Ft. from S. Line
____ Ft. from E. Line
330' Ft. from W. Line

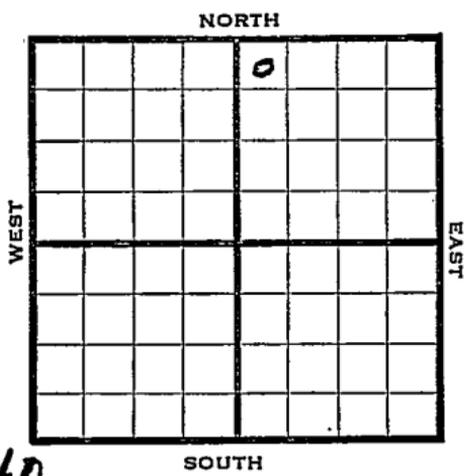

Elev. 1740

1944

REPORT

- 6/28 Location
- 7/12 RUR.
- 7/19 10" @ 200
Anhy 903
Drlg 2260
- 7/26 Lans 2957
Cong. 3267
Arb. 3276 - 89 SO 5" @ 3276 RUST
- 8/2 " " " " " " " " " "
- 8/9 TD 3289
- 8/16 7 qts 3282-89 SD
- 8/23 " " " " "
- 8/30 " " " " "
- 9/8 " " " " "
- 9/13 8 gals. oil plus 8 gal. wtr. per hr.
SD
- 9/20 Arb 3276
5" @ 3276'
TD 3307'
HFW

ABANDONED

KANSAS

Pool Name Silica

Map No. 46 Sec. 23 Twp. 19 R. 10W

Well No. 1 Johnson

Jack Robertson et al. Company

FIRST REPORT Contractor

NW NE

SECTION PLAT

330 Ft. from N. Line

_____ Ft. from S. Line

_____ Ft. from E. Line

330 Ft. from W. Line

		o	

Rice County

Location X

Rig up _____

Drilling and Remarks:

RECORD

Cased _____ in., _____ ft.

Sand _____

Gas _____

Oil _____

Total Depth _____

PRODUCTION

1st 24 hrs. Nat. _____

1st 24 hrs. after shot _____

Gas _____ Cu. Ft.

Dry Hole _____


Abandoned _____

Date

JUN 28 1944 19

S. J. LEWIS

Scout

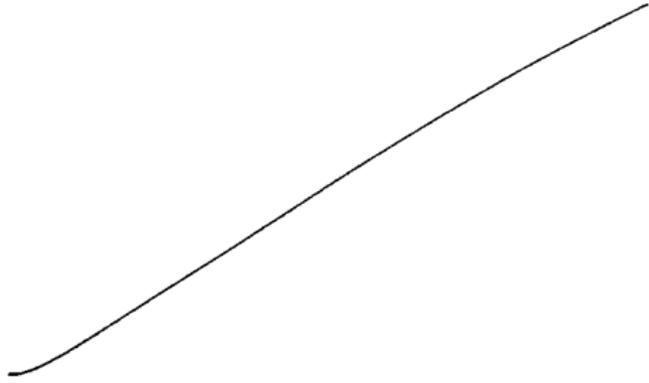

Misc. Small Maps	<i>Qma</i>
Cards	<i>Qma</i>
Tracing	<i>Qma</i>
France Map	<i>Qma</i>
Scarborough Map	<i>Qma</i>
Moody Map	<i>Qma</i>
Geological Dept.	
Moody Plat Book	

Pool Name SilicaMap No. KANSAS Sec. 23 Twp. 19 R. 10WWell No. 1 DippleJack Robertson et al. CompanyCORRECTION Contractor


NW NE

SECTION PLAT

330 Ft. from N. Line

_____ Ft. from S. Line

_____ Ft. from E. Line

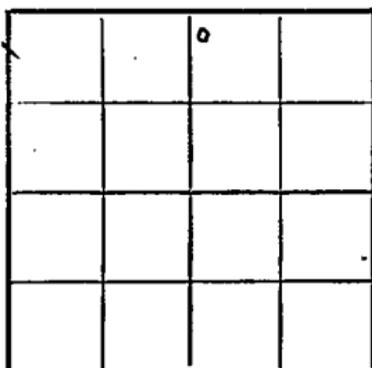330 Ft. from W. Line

Rice County

Location _____

Rig up _____

Drilling and Remarks:

Reported as
#1 Johnson

RECORD

Cased _____ in., _____ ft.

Sand _____

Gas _____

Oil _____

Total Depth _____

PRODUCTION

1st 24 hrs. Nat. _____

1st 24 hrs. after shot _____

Gas _____ Cu. Ft.

Dry Hole _____

Abandoned _____

Date

JUL 1 2 1944 19S. J. LEWIS Scout

Misc. Small Maps *Orna*
Cards *Betty*
Tracing *MB*
France Map *MB*
Scarborough Map *MB*
Moody Map *MB*
Geological Dept. *MB*
Moody Plat Book

KANSAS

Pool Name Silica PoolMap No. 46 Sec. 23 Twp. 19 R. 10WWell No. 1 DippleJack Robertson et al . Company**ABANDONED**

Contractor

NW NE

SECTION PLAT

330 Ft. from N. Line

_____ Ft. from S. Line

_____ Ft. from E. Line

330 Ft. from W. Line

		0	

Rice County

Location _____

Rig up _____

Drilling and Remarks:

*Cor. 83276**5" C 8276**HFW*

RECORD

Cased _____ in., _____ ft.

Sand _____

Gas _____

Oil _____

Total Depth 3307

PRODUCTION

1st 24 hrs. Nat. _____

1st 24 hrs. after shot _____

Gas _____ Cu. Ft.

Dry Hole _____

Abandoned _____

Date

SEP 20 1944

19

S. I. LEWIS Scout

Misc. Small Maps	Reid
Cards	Reid
Tracing	Reid
France Map	Reid
Scarborough Map	Reid
Moody Map	Reid
Geological Dept.	
Moody Plat Book	