


Section 23 Township 19 Range 10-W

Well No. #1 Stewart

Company Branine & Holl

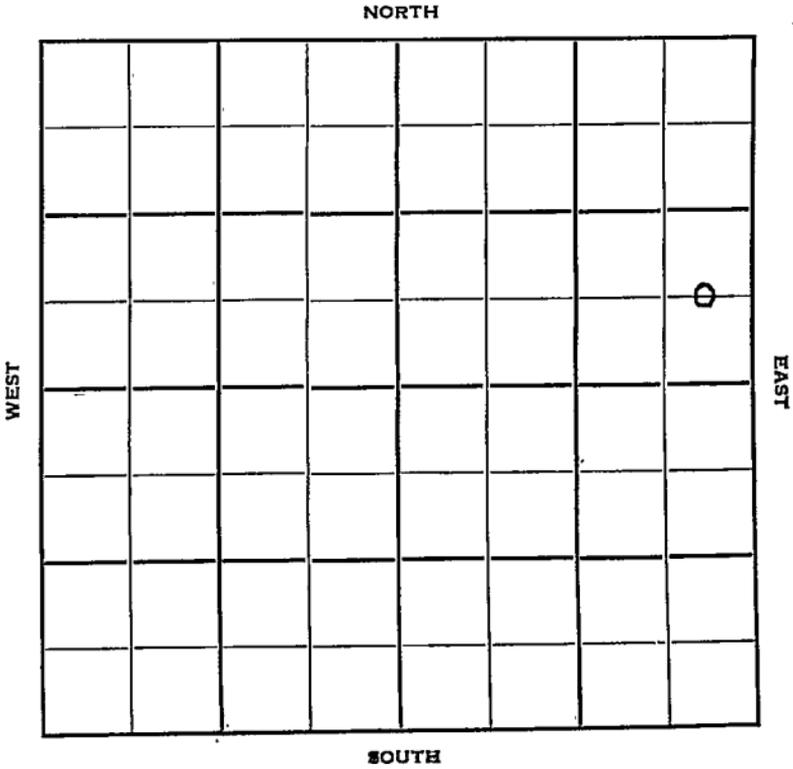

KANSAS
19

Rice

10-W ✓

Sec. 23 Twp. _____ R. _____

Well No. #1 Stewart Farm _____

Braine & Holl Company _____

Contractor _____

Silica


_____ Ft. from N. Line

660 Ft. from S. Line*

330 Ft. from E. Line

_____ Ft. from W. Line

C E L S E N E

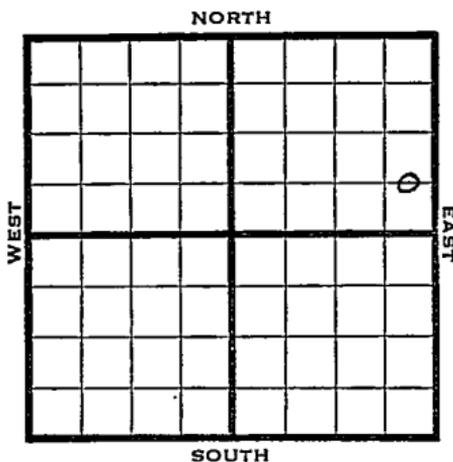

1950

Elev 1751

REPORT

7/12

RTD 3335 in Arb

7/19

Heeb 2815

Br lime 2935

Lans 2964

B KC 3230

Arb 3317-35 TD

TD 3335

D&A

ABANDONED

Map No. _____ Sec. 23 Twp. 19 R. 10W

Well No. 1 Stewart


Branine & Holl _____ Company

Contractor

C E L S E N E

E/1751

SECTION PLAT

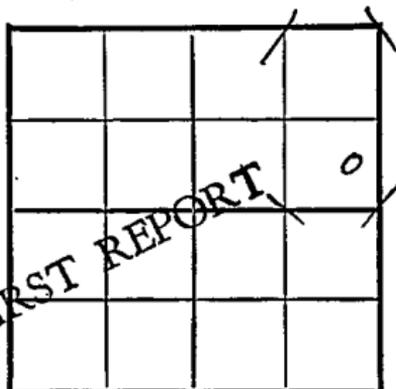

_____ Ft. from N. Line

660 _____ Ft. from S. Line

330 _____ Ft. from E. Line

_____ Ft. from W. Line

Rice County

RECORD

Location _____

Cased _____ in., _____ ft.

Rig up _____

Sand _____

Drilling and Remarks:

Gas _____

Oil _____

RTD 3335 in Arb.

Total Depth _____

PRODUCTION

1st 24 hrs. Nat. _____

1st 24 hrs. after shot _____

Gas _____ Cu. Ft.

Dry Hole _____

Abandoned _____

Date

JUL 12 1950 19

J. E. TYRA Scout

Kansas

Map No. _____ Sec. 23 Twp. 19 R. 10W

Well No. 1 Stewart

Branine & Holl

Company

Contractor

C E L S E N E

E1. 1751


SECTION PLAT

_____ Ft. from N. Line

660 Ft. from S. Line

330 Ft. from E. Line

_____ Ft. from W. Line

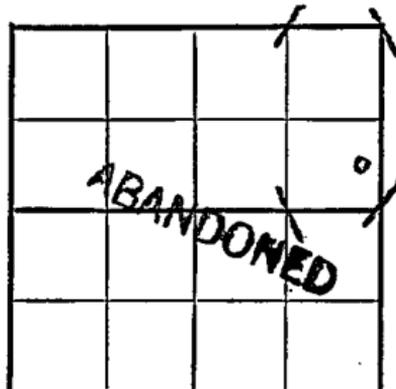

Rice County

Location _____

Rig up _____

Drilling and Remarks:

Heeb. 2815

Br. lim 2935

Lans. 2964

B KC 3230

Arb. 3317-35 TD

D & A

RECORD

Cased _____ in., _____ ft.

Sand _____

Gas _____

Oil _____

Total Depth 3335

PRODUCTION

1st 24 hrs. Nat. _____

1st 24 hrs. after shot _____

Gas _____ Cu. Ft.

Dry Hole _____

Abandoned _____

Date

JUL 10 1950

19

J. E. TYRA Scout