


Section 23 Township 19 Range 10 WWell No. 1 StraubCompany Woodriver Oil & Ref.

Silica Pool

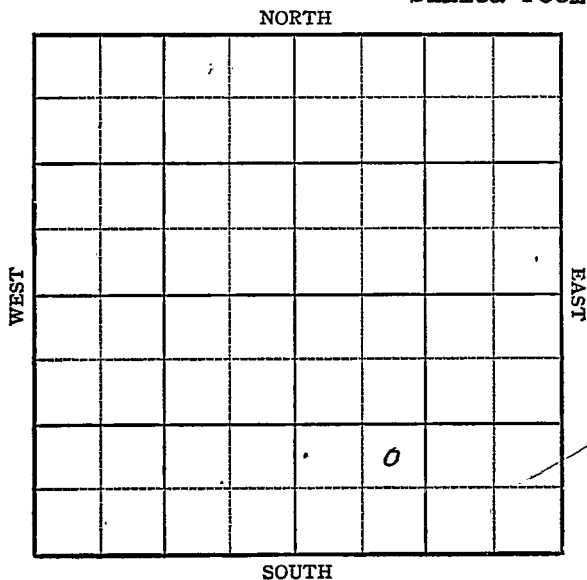

Sec. 23 Twp. 19 R. 10-W

Well No. #1 Streub St reb Farm

Woodriver Oil & Ref.

Company

Silica


 Ft. from N. Line

990 Ft. from S. Line

 Ft. from E. Line

990 Ft. from W. Line

NE SW SE

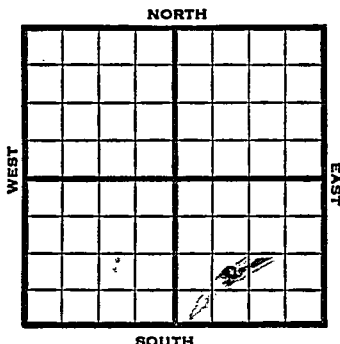

1948 Eli 1747' REPORT

12/22 8" @ 221

Drlg 1150'

12/29 Drlg 2710'

Arbuckle 3274'-78'

1/5 Lansing 3136'

Arbuckle 3274'-78'

TD 3278'

5" @ 3274'

1/12 TD 3282. 2000 acid sw &
15 bbls oil PH

1/19 TD 3282'

Arb. 3274'

5" @ 3274'

2000 acid

Pump 70 oil Pot

42° Gr.

Comp

COMPLETED

Map No. _____ Sec. 23 Twp. 19 R. 10W

Well No. 1 Straub

Woodriver Oil & Ref. Company

FIRST REPORT

Contractor

NE SW SE


SECTION PLAT

_____ Ft. from N. Line

990 Ft. from S. Line

_____ Ft. from E. Line

990 Ft. from W. Line

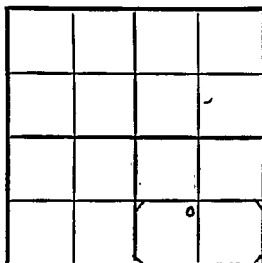

Rice County

RECORD

Location _____

Cased _____ in., _____ ft.

Rig up _____

Sand _____

Drilling and Remarks:

Gas _____

Oil _____

8" @ 221

Total Depth _____

drlg. 1150

PRODUCTION

1st 24 hrs. Nat. _____

1st 24 hrs. after shot _____

Gas _____ Cu. Ft.

Dry Hole _____

Abandoned _____

Date

DEC 22 1948 19

S. J. LEWIS

Scout

Map No. 46 Sec. 23 Twp. 19 R. 10W

Well No. 1 Strob

Woodriver Oil & Ref. Company

CORRECTION

Contractor

NE SW SE


SECTION PLAT

 Ft. from N. Line

990 Ft. from S. Line

 Ft. from E. Line

990 Ft. from W. Line

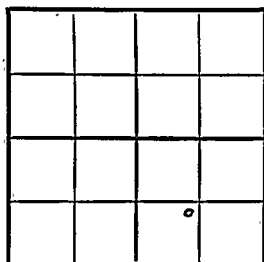

Rice County

RECORD

Location

Cased in., ft.

Rig up

Sand

Drilling and Remarks:

Gas

Oil

Total Depth

Reported
#1 Straub

PRODUCTION

1st 24 hrs. Nat.

1st 24 hrs. after shot

Gas Cu. Ft.

Dry Hole

Abandoned

Date

JAN 1 9 1949 19

S. J. LEWIS Scout

Kansas

Silica Pool

Map No. 46 Sec. 23 Twp. 19 R. 10WWell No. 1 Strob


Woodriver Oil & Ref.

Company

COMPLETE

Contractor

NE SW SE

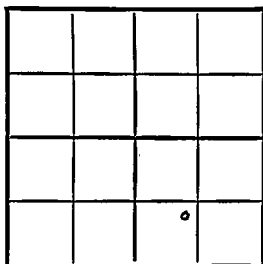E11742
SECTION PLAT Ft. from N. Line990 Ft. from S. Line Ft. from E. Line990 Ft. from W. Line

Rice County

Location Rig up

Drilling and Remarks:

Per 32745" @ 32742000 acidPump 70 oil 10042 3/4

RECORD

Cased in., ft.Sand Gas Oil Total Depth 1922

PRODUCTION

1st 24 hrs. Nat. 1st 24 hrs. after shot Gas

Cu. Ft.

Dry Hole Abandoned

Date

JAN 19 1949

19

S. J. LEWIS

Scout