


KANSAS

Rice

Section 23 Township 19 Range 10WWell No. 5 ThompsonCompany Woodriver Oil & Ref.

Silica Pool

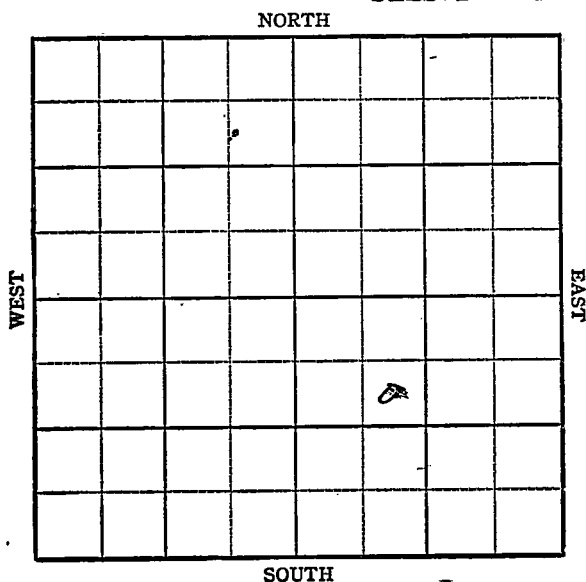

KANSAS

Rice

✓
10W

Sec. 23 Twp. 19 R. 10W

Well No. #5 Thompson Farm Woodriver Oil & Ref.
Company

Silica Pool


990' Ft. from N. Line

 Ft. from S. Line

 Ft. from E. Line

990' Ft. from W. Line

SE NW SE

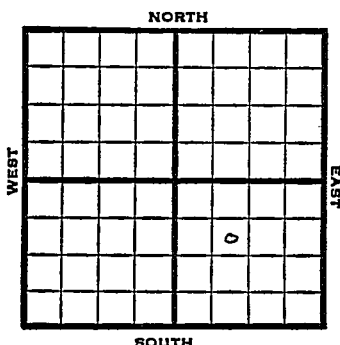

1948 Elev. 1751' REPORT

12/8 Surface Hole

12/15 8" @ 225'
Drlg 3110

12/22 Lansing 2962'
Arbuckle 3260'
5" @ 3260'
TD 3276'

12/29 1500 acid
Arb. 3283' (Corrected)
TD 3287'

1949


1/5 Arb. 3283'
5" @ 3260'
1500 acid
Pump 230 oil P_{ot}.
Gr. 42°
TD 3287'

COMPLETED

Map No. _____ Sec. 23 Twp. 19 R. 10WWell No. 5 ThompsonWoodriver Oil & Ref. CompanyFIRST DEPOSIT Contractor

SE NW SE

SECTION PLAT

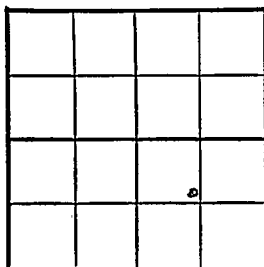990 Ft. from N. Line Ft. from S. Line Ft. from E. Line990 Ft. from W. Line

Rice County

Location _____

Rig up _____

Drilling and Remarks:

surface hole

RECORD

Cased _____ in., _____ ft.

Sand _____

Gas _____

Oil _____

Total Depth _____

PRODUCTION

1st 24 hrs. Nat. _____

1st 24 hrs. after shot _____

Gas _____ Cu. Ft.

Dry Hole _____

Abandoned _____

Date

DEC 8 1942 19S. J. LEWIS Scout

Kansas

10W

Map No. 46 Sec. 23 Twp. 19 R. Well No. 5 ThompsonWoodriver Oil & Ref. Company


COMPLETE

Contractor

SE NW SE

2 1/2 125'

SECTION PLAT

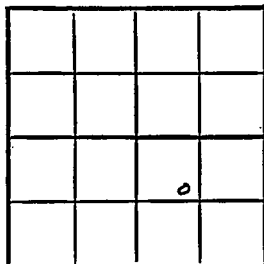990 Ft. from N. Line Ft. from S. Line Ft. from E. Line990 Ft. from W. Line

Rice County

Location Rig up

Drilling and Remarks:

*Cu 43283**5" C 3260**1500 acid**Run 200 oil 80**42 1/2*

RECORD

Cased in., ft.Sand Gas Oil ✓Total Depth 3287

PRODUCTION

1st 24 hrs. Nat. 1st 24 hrs. after shot Gas Cu. Ft.Dry Hole Abandoned

Date

JAN 5 1949

19

S. J. LEWIS

Scout