

KANSAS


Rice County

FORM 51 5M PETROL

Section 23 Township 19 Range 9W

Well No. 1 Patterson "B"

Company Sharon Drlg.

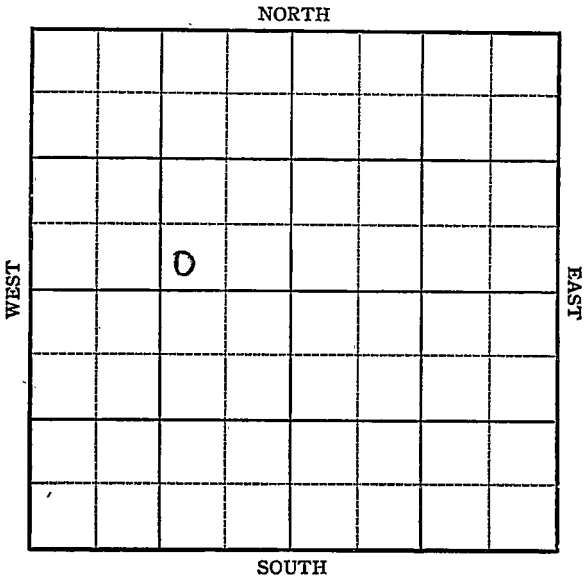

KANSAS

Rice

Sec. 23 Twp. 19 R. 9W

Well No. 1 Patterson "B" Farm

Sharon Drlg. Company

Chase

Ft. from N. Line


330

Ft. from S. Line

990

Ft. from E. Line

Ft. from W. Line

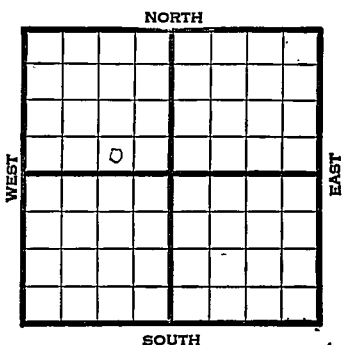

SW SE NW

1945

Elev. 1741

REPORT

5/29

Location

6/8

Surface Hole

6/20

Leas 2909

Arb. 3286

TD 3340'

ABANDONED

Kansas Pool Name ChaseMap No. 49 Sec. 23 Twp. 19 R. 9WWell No. 1 Patterson "B"Sharon Drlg. Company

FIRST REPORT

Contractor

SW SE NW

SECTION PLAT

	6		

 Ft. from N. Line330 Ft. from S. Line990 Ft. from E. Line Ft. from W. Line

Rice County

Location XRig up

Drilling and Remarks:

RECORD

Cased in., ft.Sand Gas Oil Total Depth

PRODUCTION

1st 24 hrs. Nat. 1st 24 hrs. after shot Gas Cu. Ft.Dry Hole Abandoned

Date

MAY 29, 1945 19 S. J. LEWIS Scout

Kansas Pool Name ChaseMap No. _____ Sec. 23 Twp. 19 R. 9WWell No. 1 Patterson "B"Sharon Drlg.

Company

ABANDONED

Contractor

SW SE NW

E11741
SECTION PLAT

	6		

_____ Ft. from N. Line

330

_____ Ft. from S. Line

990

_____ Ft. from E. Line

_____ Ft. from W. Line

Rice County

Location _____

Rig up _____

Drilling and Remarks:

Lins 2909Per 3286**RECORD**

Cased _____ in., _____ ft.

Sand _____

Gas _____

Oil _____

Total Depth 3240**PRODUCTION**

1st 24 hrs. Nat. _____

1st 24 hrs. after shot _____

Gas _____ Cu. Ft.

Dry Hole _____

Abandoned _____

Date

JUN 20 1945

19

S. J. LEWIS

Scout