

KANSAS

Rice County

Sec. 23 Twp. 19 R. 9-W

Well No. 2 Patterson "A" Farm
Bishop & Sohio Company


Chase Pool
330 Ft. from N. Line

Ft. from S. Line

330 Ft. from E. Line

Ft. from W. Line

NE NW

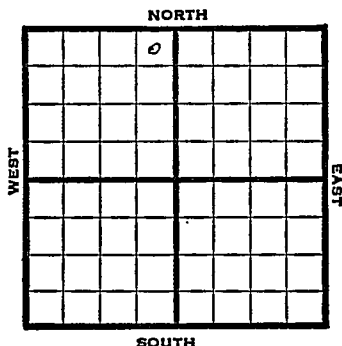

1947

Elev 1740' REPORT

7/30

8" @ 231
Drlg. 400

8/6

Lansing 2910'
Simpson 3228'
Arbuckle 3233-38' TD
Run csg.

8/13

5" @ 3233
TD 3245
500 acid

8/20

Arb 3239'
5" @ 3233'
Acid 500
Pump 50 Pot.
Gr. 42
T.D. 3245'
Completed

COMPLETED

Kansas

Map No. _____ Sec. 23 Twp. 19 R. 9WWell No. 2 Patterson "A"Bishop & Sohio

Company

FIRST REPORT

Contractor

NE NW

SECTION PLAT

330 Ft. from N. Line

_____ Ft. from S. Line

330 Ft. from E. Line

_____ Ft. from W. Line

	6		

Rice County

Location _____

Rig up _____

Drilling and Remarks:

8" @ 231

drlg. 400

RECORD

Cased _____ in., _____ ft.

Sand _____

Gas _____

Oil _____

Total Depth _____

PRODUCTION

1st 24 hrs. Nat. _____

1st 24 hrs. after shot _____

Gas _____ Cu. Ft.

Dry Hole _____

Abandoned _____

Date

JUL 30 1947

19

S. J. LEWIS

Scout

Map No. 49 Sec. 23 Twp. 19 R. 9W

Well No. 2 Patterson "A"

Bishop & Sohio Company

COMPLETE

Contractor

NE NW


E11740
SECTION PLAT

330 Ft. from N. Line

 Ft. from S. Line

330 Ft. from E. Line

 Ft. from W. Line

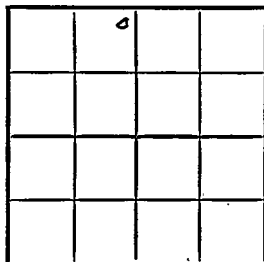

Rice County

Location

Rig up

Drilling and Remarks:

CR 83289
5' 03283
500 225-6
Pump 50 BX

42 2/3

RECORD

Cased in., ft.

Sand

Gas

Oil

Total Depth 18245

PRODUCTION

1st 24 hrs. Nat.

1st 24 hrs. after shot

Gas Cu. Ft.

Dry Hole

Abandoned

Date

AUG 20 1947

19

S. I. LEWIS

Scout