


KANSAS

Rice

Section 23 Township 19 Range 9WWell No. 3 PattersonCompany Bishop & SohioChase
NORTH

WEST

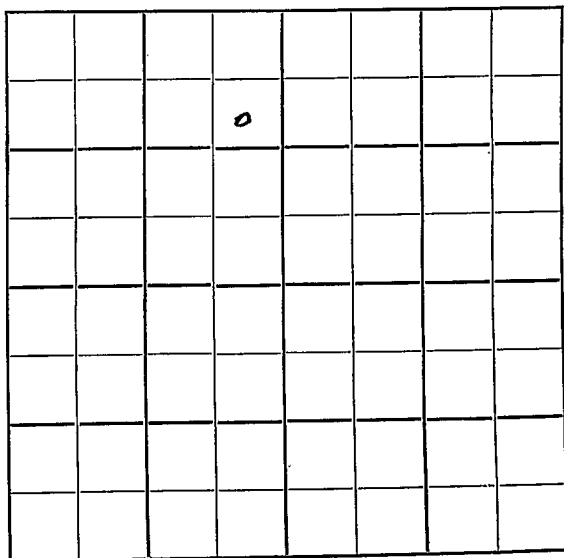

EAST

SOUTH

Sec. 23 **KANSAS** Rice 19 R. 9W ✓

Well No. #3 Patterson Farm

Bishop & Sohio Company

(Bishop Drlg., Cont.)


Chase Pool

990' Ft. from N. Line

Ft. from S. Line

330' Ft. from E. Line

Ft. from W. Line

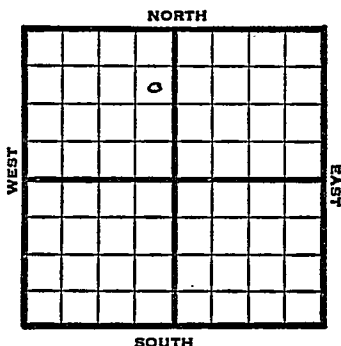

SE NE NW

1949 Elev 1735' REPORT

5/11 8" @ 238'
Drlg. 1350'
5/18 Lansing 2903'
Drlg 2990'
5/25 "
6/1 "
6/8 Arb. 3267'
5"@ 3269'
TD 3276'
500 acid
Pump 50 oil Pot
42° Gr.
Comp

COMPLETED

Map No. _____ Sec. 23 Twp. 19 R. 9WWell No. 3 Patterson_____Bishop & Schio_____
Company_____Bishop_____
Contractor

SE NE NW

FIRST REPORT
SECTION PLAT990 Ft. from N. Line_____
Ft. from S. Line330 Ft. from E. Line_____
Ft. from W. Line

	6		

Rice County

Location _____

Rig up _____

Drilling and Remarks: _____

8" @ 238

drlg. 1350

RECORD

Cased _____ in., _____ ft.

Sand _____

Gas _____

Oil _____

Total Depth _____

PRODUCTION

1st 24 hrs. Nat. _____

1st 24 hrs. after shot _____

Gas _____ Cu. Ft.

Dry Hole _____

Abandoned _____

Date

MAY 11 1949 19S. J. LEWIS Scout

Rice County Kansas State

Map No. 149 Sec. 23 Twp. 19 R. 9W

Well No. 3 Patterson

Bishop & Sohio Company

COMPLETE.

Contractor

SE NE NW

E. 1735

SECTION PLAT

990 Ft. from N. Line

 Ft. from S. Line

330 Ft. from E. Line

 Ft. from W. Line

Chase Pool

Remarks:

Cr 83267

5' @ 3268

71 D 3276

500 @ 3268

Pump 500 ft. P.D.

42° SW

Date

JUN 8

1949

Scout

S. J. LEWIS