

KANSAS


FORM 51 5M PETROL

Rice

Section 23 Township 19 Range 9W

Well No. #1 Patterson

Company Sharon Drilg.

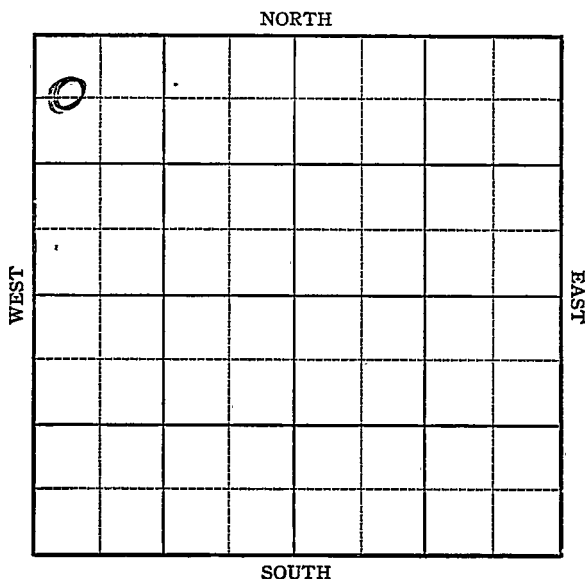

Rice

Sec. 23 Twp. 19 R. 9W

Well No. #1 Patterson Farm

Sharon Drlg. Company

Chase


660 Ft. from N. Line

 Ft. from S. Line

 Ft. from E. Line

330 Ft. from W. Line

elev. 1727

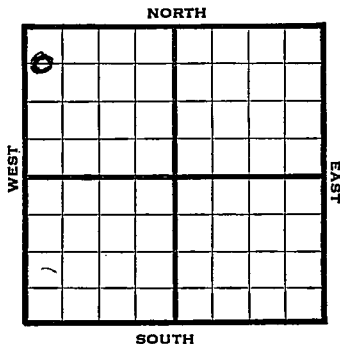

1944

REPORT

3/29

Cellar

4/5

8" @ 205
Drlg. 1241

4/12

Drlg. 2504

4/19

Lans 2891
Arb 3227-40 TD VSSO
5" @ 3231
Rust

4/26

"

5/3

TD 3264
1 oil perhr 2 hrs 1000 acid.

5/10

No Help
1000 acid no help

5/17

T.D. 3272 - 1000 acid
Pump 5 oil per hr for 24 hrs.

OVER

1944

5/31

Arb 3227

5" @ 3231

TD 3272

3000 acid

Pump 114 Pot

Grav. 42

COMPLETED

KANSAS
 Map No. 279 Sec. 23 Twp. 19 R. 9W

Well No. 1 Patterson

Sharon Drlg. Company

FIRST REPORT Contractor

C W L NW NW


SECTION PLAT

660 Ft. from N. Line

_____ Ft. from S. Line

_____ Ft. from E. Line

330 Ft. from W. Line

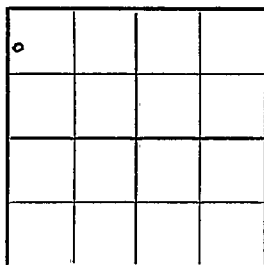

Chase Pool

Location _____

Rig up _____

Drilling and Remarks:

Cellar

RECORD

Cased _____ in., _____ ft.

Sand _____

Gas _____

Oil _____

Total Depth _____

PRODUCTION

1st 24 hrs. Nat. _____

1st 24 hrs. after shot _____

Gas _____ Cu. Ft.

Dry Hole _____

Abandoned _____

Date

MAR 29 1944 19

S. J. LEWIS Scout

Misc. Small Maps. *Oma*
Cards *Mudge*
Tracing *Mudge*
France Map *Mudge*
Carborough Map *Mudge*
Moody Map *Mudge*
Geological Dept.
Moody Plat Book

KANSAS

Pool Name Chase PoolMap No. 49 Sec. 23 Twp. 19 R. 9WWell No. 1 PattersonSharon Drlg. Company**COMPLETED**

Contractor

C W L NW NW

SECTION PLAT

o			

660 Ft. from N. Line Ft. from S. Line Ft. from E. Line330 Ft. from W. Line

Rice County

Location Rig up

Drilling and Remarks:

*Ar 83227**5" 83231**3000 acs**Pump. 1 1/4 Bx**42 2/3*

RECORD

Cased in., ft.Sand Gas Oil Total Depth 3272

PRODUCTION

1st 24 hrs. Nat. 1st 24 hrs. after shot Gas Cu. Ft.Dry Hole Abandoned

Date

MAY 3 1 1944 19

S. J. LEWIS

Scout

Misc Small Maps

Cards

Tracing

France Map

Scarborough Map

Moody Map

Geological Dept.

Moody Plat Book