

KANSAS

Rice County


FORM 51 5M BRIX

Section 23 Township 19 Range 9W

Well No. # 1 Reiss

Company Cities Service Oil

O. W. P. B.

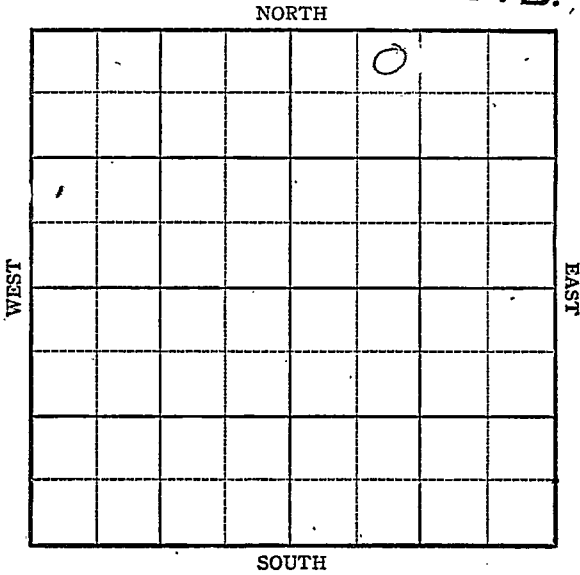

KANSAS

Rice County


Sec. 23 Twp. 19S R. 9WWell No. #1, Reiss Farm

Cities Service Oil Company

Chase **O.W.P.**330 Ft. from N. Line Ft. from S. Line Ft. from E. Line990 Ft. from W. Line

NE NW NE

Elev. 1744

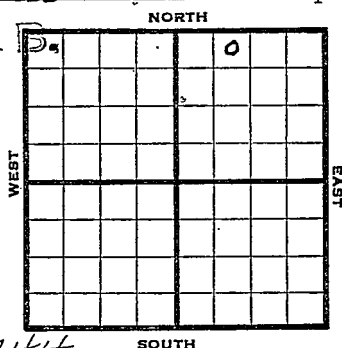

1945

R E P O R T

1-10	Location
1/26	RUR
1/31	8" @ 190'
	Drlg. 1280'
2/7	Drlg 2405
2/14	2933 fsg
2/21	Land 2912
	Arb 3274 - 76 TD
	Run 5"
2/28	Cong 3224
	Simp. 3244
	4" @ 3275 RUST
3/7	" " " "
3/14	Arb 3278 Corrected
	4" @ 3280 TD 3282 - 500' oil 1 hr
3/23	" " " " " "
3/29	" " " " " "
4/5	" " " " " "
4/11	Arb 3278
	4" @ 3280
	TD 3282
	Pump 39 Pot.
	Grav. 42.4

COMPLETED
OVER

1950

O. W. P. B.


8/9 Cong. 3238' Simp 3248'
Arb. 3278'
5" @ 3280' OTD 3282
Was Arb. prod.
PB 3256' 38/3234-42
FU 870' oil 38 hrs
Comp. 10 BOPD

FIRST REPORT
COMPLETED

Pool Name ChaseMap No. 49 Sec. 23 Twp. 19 R. 9WWell No. 1 ReissCities Service Oil CompanyFIRST REPORT Contractor

NE NW NE

SECTION PLAT

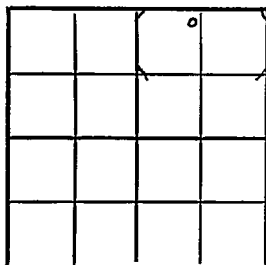330 Ft. from N. Line Ft. from S. Line Ft. from E. Line990 Ft. from W. LineRiceLocation XRig up

Drilling and Remarks:

RECORD

Cased in., ft.Sand Gas Oil Total Depth

PRODUCTION

1st 24 hrs. Nat. 1st 24 hrs. after shot Gas Cu. Ft.Dry Hole Abandoned

Date

JAN 10 194519S. J. LEWISScout

Misc. Small Maps	LR
Cards	LR
Tracing	LR
France Map	✓
Scarborough Map	LR
Pierce Map	LR
Geological Dept.	
Pierce Piat Book	

Pool Name Chase

Kansas

Map No. 49 Sec. 23 Twp. 19 R. 9WWell No. 1 Reiss

Cities Service Oil Company

COMPLETED

Contractor

NE NW NE

SECTION PLAT

			0

330 Ft. from N. Line Ft. from S. Line Ft. from E. Line990 Ft. from W. LineRice Elev. 1771Location Rig up

Drilling and Remarks:

*Cr 43278**4" @ 3280**Pump. 89 P.D.**42 1/2*

RECORD

Cased in., ft.Sand Gas Oil Total Depth 3282

PRODUCTION

1st 24 hrs. Nat. 1st 24 hrs. after shot Gas Cu. Ft.Dry Hole Abandoned


Date

APR 11 1945

19

S. J. LEWIS

Scout

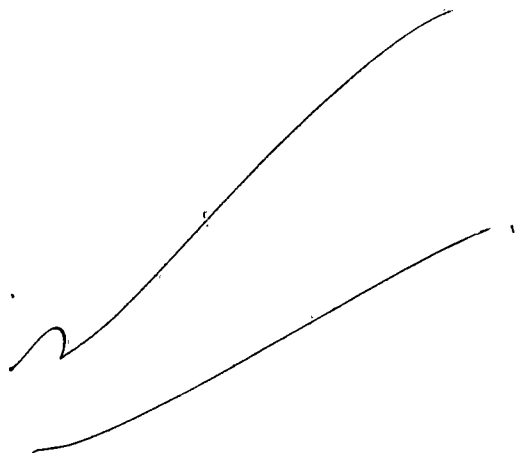

Misc. Small Maps	
Cards	<i>Petty</i>
Tracing	<i>P. B.</i>
France Map	<i>[initials]</i>
Scarborough Map	<i>[initials]</i>
Moody Map	<i>P. B.</i>
Geological Dept.	✓
Moody Plat Book	

O. W. P. B.

County Rice State KansasSec. 23 (Blk. 19) (Sur. 9W) (Twp.) 19 Map No.Operator Cities ServiceWell No. 1 Farm Reiss "A"Elev. 1744 Location NE NW NE

COMPLETE

FIRST REPORT

530 Ft. From N Line NE990 Ft. From W Line Quarter1st. Report AUG 9 1950

Completion

Remarks OWPB

Spudding Date

Drlg. Data

Cong. 3238 Simp. 3248 Arb. 32785" @ 3280 OTD 3282 Was Arb. prod.PB 3256 38/ 3234-42 FU 870⁺ oil 38 hr.Comp. 10 bopd

J. E. TYRA

Aug 11 1950

Scout Cards	
Land Small Map	
Land Wall Map	
Tracings	
France Map	
Pierce Map	
Misc.	

Drig. Data