

KANSAS

Rice

Section 23 Township 19 Range 9WWell No. 1 Reece "B"Company Cities Service
Chase

NORTH

WEST

EAST

SOUTH

Rice **KANSAS**

Sec. 23 Twp. 19 R. 9W

Well No. #1 Reece "B" Farm

Cities Service

Company


Chase Pool (Rine Drlg., Cont.)

 Ft. from N. Line

990' Ft. from S. Line

 Ft. from E. Line

330' Ft. from W. Line

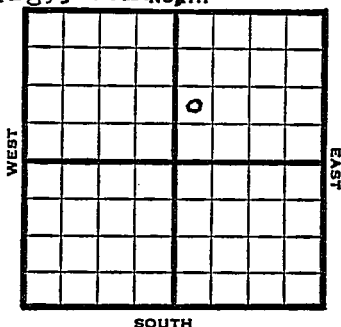

NW SW NE

SOUTH

1949	Elev 1734' REPORT
5/18	8" @ 195'
5/25	Drlg 2819'
6/1	Lans 2903'
	Arb. 3237'
	TD 3240
	5"@ 3238'
6/8	Arb. 3237'
	5"@ 3238'
	TD 3246'
	Pump 172 Oil Pot
	42° Gr.
	Comp
	COMPLETED

Map No. _____ Sec. 23 Twp. 19 R. 9W

Well No. 1 Reece "B"

Cities Service Company

Rine Drlg. Contractor

NW SW NE


**FIRST REPORT
SECTION PLAT**

_____ Ft. from N. Line

990 Ft. from S. Line

_____ Ft. from E. Line

330 Ft. from W. Line

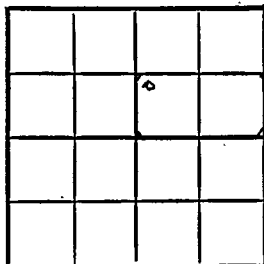

Rice County

Location _____

Rig up _____

Drilling and Remarks:

8" @ 195

RECORD

Cased _____ in., _____ ft.

Sand _____

Gas _____

Oil _____

Total Depth _____

PRODUCTION

1st 24 hrs. Nat. _____

1st 24 hrs. after shot _____

Gas _____ Cu. Ft.

Dry Hole _____

Abandoned _____

Date

MAY 18 1949

19

S. J. LEWIS

Scout

Rice County Kansas State
 Map No. 149 Sec. 23 Twp. 19 R. 9W

Well No. 1 Reece "B"

Cities Service Company

COMPLETE

NW SW NE Contractor E11734

SECTION PLAT

 Ft. from N. Line

990 Ft. from S. Line

 Ft. from E. Line

330 Ft. from W. Line

Chase Pool

Remarks:

Cr 83 287

5" C3238

7/173246

Pump 123 oil 28

420-88

Date
 JUN 8 1949

Scout S. J. LEWIS