


Section 23 Township 19 Range 9 WWell No. # 1 ShumwayCompany Todd Drlg.

NORTH

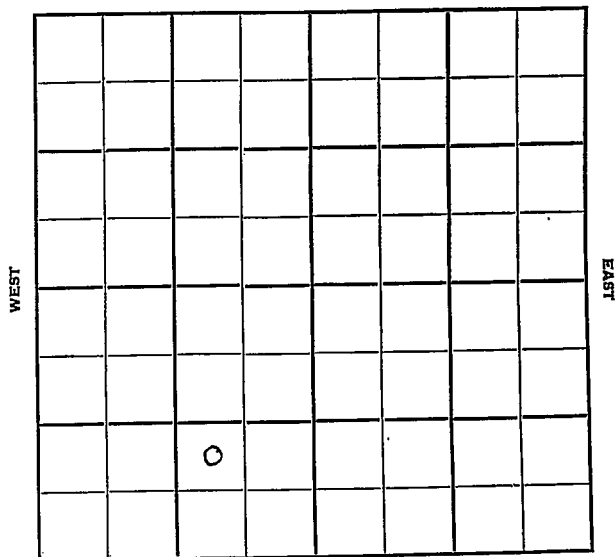

SOUTH

Rice

KANSAS

Sec. 23 Twp. 19 R. 9 W ✓

Well No. # 1 Shumway Farm

Todd Drlg. Company

Contractor

Chase Pool


Ft. from N. Line

990 Ft. from S. Line

990 Ft. from E. Line

Ft. from W. Line

NW SE SW

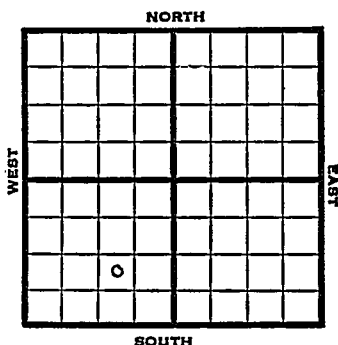

1951

Elev. 1729'

REPORT

4/11

Location

6/13

Spud 4-18-51

Oil well TD 3290' 8" @ 206

Anhy 350-65 Heeb 2749' Tor. 2769'

Br. line 2874' Lans. 2905'

DST 2976-83 open 1 hr. rec 50' SO & GCM

Arb. 3255'

DST 3256-64 open 1 hr. rec 30' OCM


TD 3264' 5" @ 3256 DD 3268'

500 A DD 3271' FU 200' oil overnite

DD 3290' B/1½ BOPH

Comp. 20 BOPD

COMPLETED

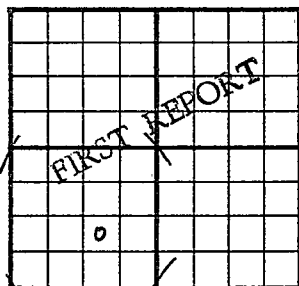County Rice State KansasSec. 23 (Blk. Twp.) 19 (Sur. Rge.) SW Map No.Operator Todd Drlg.Well No. 1 Farm ShumwayElev. Location NW SE SW990 Ft. From S Line SW990 Ft. From E Line Quarter1st. Report APR 11 1951


Completion

Remarks

Spudding Date

Drlg. Data Chase PoolLocation

J. E. TYRA

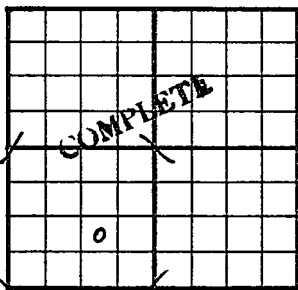County Rice State KansasSec. 23 (Blk.
Twp.) 19 (Sur.
Rge.) 9W Map No.Operator Todd Drlg.Well No. 1 Farm ShumwayElev. 1729 Location NW SE SW990 Ft. From S Line SW990 Ft. From E Line Quarter

Ist. Report

Completion JUN 13 1951Remarks Chase PoolSpudding Date 4-18-51Drlg. Data Oil well TD 32908 " @ 206 Anhy 350-65 Heeb. 2749Tor. 2769 Br. lime 2874Lans. 2905 DST 2976-83 open 1 hr.Rec. 50' so & Gcm Arb. 3255DST 3256-64 open 1 hr. Rec. 30'ocm TD 3264 5" @ 3256 DD 3268500 A DD 3271 FU 200' oil overnitDD 3290 B/ 1 $\frac{1}{2}$ boph Comp. 20 bopd

J. E. TYRA