

DX 78-1


Rice

KANSAS

Section 23 Township 19 Range 9W

Well No. #3 Shumway

Company Petroleum Inc.

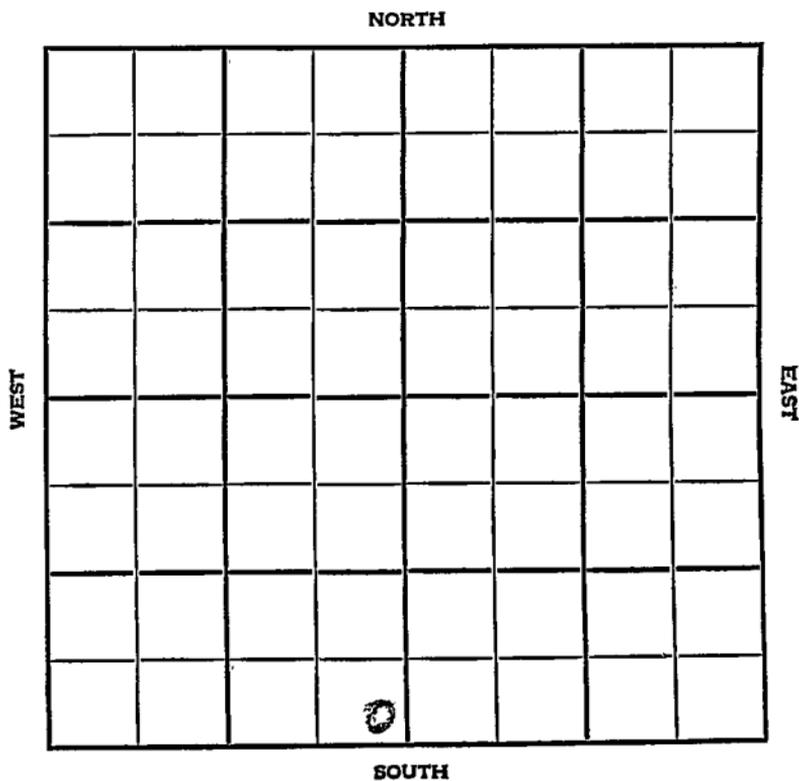

Top Pool

Co. Forest


FORM 513 REV. SUNRAY

FIRST REPORT

County Rice ✓ Elev. 1712
 Sec. 23 Twp. 19 Rge. 9W
 Company Petroleum Inc.
 Farm Name Shumway No. 3

TOPS	DEPTH	DATUM
Cim Anhydrite		
Ft. Riley		
Howard		
Topeka		
Heebner Sh.		
Toronto Ls.		
Brown Lime		
Lansing		
Kans. City		
B. K. C.		
Congl.		
Miss.		
Kinderhook		
Misener		
Hunton		
Sylv. Maquo		
Viola		
Simpson		
Smp.		
Gorham		
Arbuckle		
Basal Sand		
Pre. Cam.		
T. D.		

Loc. in Section
SE SE SW
 Drlg. Contr. Co. tools
 Pool Chase-Silica

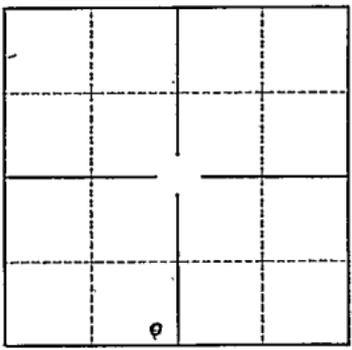

Date Comm.
 Date Comp.

WORT

[Handwritten signature]

Co.
 Sec.
 No.
 S.
 T.
 R.

County Rice Elev. 1712
 Sec. 23 Twp. 19 Rge. 9W
 Company Petroleum Inc.
 Farm Name Shumway No. 3

Co.

TOPS	DEPTH	LOG	DATUM
Anh.			
Tp.			
H.	<u>2745</u>		<u>1033</u>
Tr.			
Dg.			
Bl.	<u>2873</u>		<u>1161</u>
L.	<u>2905</u>		<u>1193</u>
K.C.			
B.K.C.			
Ce.			
C.			
M.			
M.			
K.			
Mz.			
Me.			
V.			
S.	<u>3243</u>		<u>1531</u>
S.			
A.			
R.			
PE.			
G.			
T.D.	<u>3290</u>		

Loc. in Sec. _____

SE SE SW

Geol. _____

Contr. _____

Co. tools

Pool _____

Chase-Silica

ABANDONED

Lse.

No.

Sec.

T.

R.

Date Comm. 5-18-55 JUN- 1 1955
8 5/8" @ 182/160 DST 3235-50 open 1 hr.
Rec. 63' mcsw 870/20" DST 3263-90
open 1/2 hr. Rec. 10' mud 40/20"

D & A