

KANSAS

Rice

FORM 51 25M 3-49 PETROL

Section 23 Township 19S Range 9W

Well No. #1 Everett

Company Reserve Drlg. Co.

NORTH

WEST

EAST

				0			

SOUTH

KANSAS

Rice ✓

Sec. 23 Twp. 19 R. 9-W

Well No. #1 Everett Farm

Reserve Drlg

Company

Cont Reserve Drlg


330 Chase Pool
Ft. from N. Line

_____ Ft. from S. Line

_____ Ft. from E. Line

330 Ft. from W. Line

NW SE

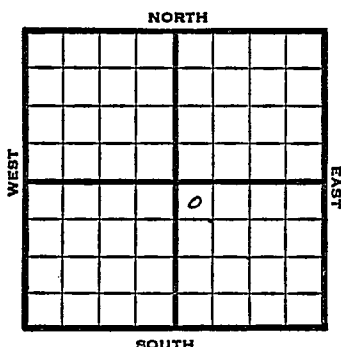

1949	Elev. 1730' REPORT
10/12	Location
10/19	8" @ 210'
	Drlg 2878'
10/26	Lansing 2912'
	Simpson Sd 3251'
	TD 3255'
	5" @ 3251'
11/1	TD 3263'
11/9	TD 3295'
11/16	TD 3295'
	Simp 3231'
	Aband.
	ABANDONED

Map No. _____ Sec. 23 Twp. 19 R. 9W

Well No. 1 Everett

Reserve Drlg. _____ Company _____

Reserve Drlg. _____ Contractor _____

NW SE


**FIRST REPORT
SECTION PLAT**

330 Ft. from N. Line

_____ Ft. from S. Line

_____ Ft. from E. Line

330 Ft. from W. Line

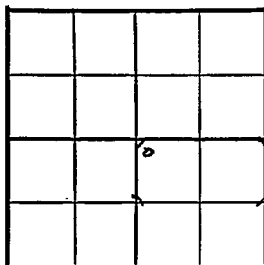

Rice County

Location X

Rig up _____

Drilling and Remarks:

RECORD

Cased _____ in., _____ ft.

Sand _____

Gas _____

Oil _____

Total Depth _____

PRODUCTION

1st 24 hrs. Nat. _____

1st 24 hrs. after shot _____

Gas _____ Cu. Ft.

Dry Hole _____

Abandoned _____

Date

OCT 1 2 1949 19 S. J. LEWIS Scout

Map No. _____ Sec. 23 Twp. 19 R. 9W

Well No. 1 Everett

Reserve Drlg.

Company

ABANDONED

Contractor

NW SE

EL 1780


SECTION PLAT

330 Ft. from N. Line

_____ Ft. from S. Line

_____ Ft. from E. Line

330 Ft. from W. Line

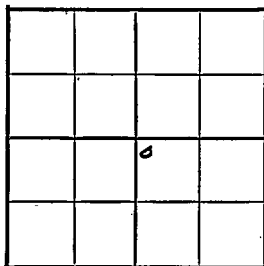

Rice County

Location _____

Rig up _____

Drilling and Remarks:

Comp 323%

RECORD

Cased _____ in., _____ ft.

Sand _____

Gas _____

Oil _____

Total Depth 929.5

PRODUCTION

1st 24 hrs. Nat. _____

1st 24 hrs. after shot _____

Gas _____ Cu. Ft.

Dry Hole _____

Abandoned _____

Date

NOV 16 1949 19

S. J. LEWIS Scout