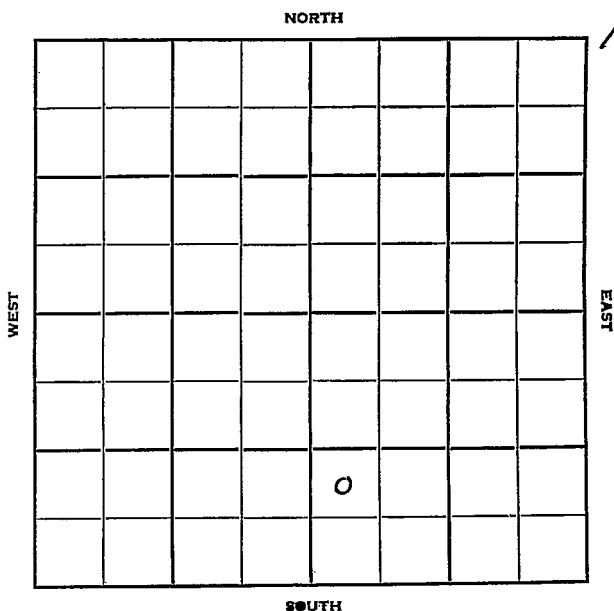


Section 23 Township 19 Range 2-WWell No. #6 KnudsonCompany C R A

KANSAS

McPherson

Sec. 23 Twp. 19 R. 2-W ✓

Well No. #6 Knudson Farm

C R A

Company

Rich

Contractor


       Ft. from N. Line

990 Ft. from S. Line

       Ft. from E. Line

330 Ft. from W. Line

NW SW SE

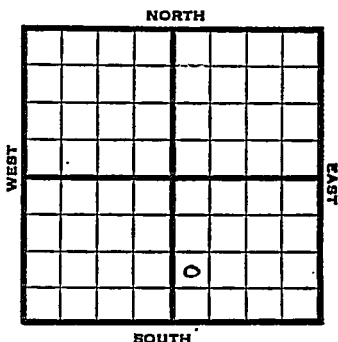

1951

Elev. 1550' REPORT

1/10

MIR

2/7

Spud 1-10-51

Oil Well TD 2960


10" @ 124' Lans. 2300'

Miss 2901-48'

7" @ 2927 FU 300' mud & gassy oil

TD 2960 Comp. 40 bopd

**COMPLETED**

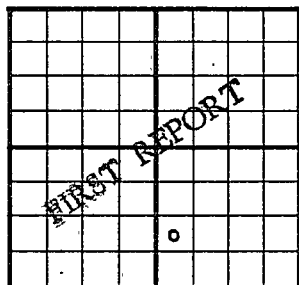County McPherson State KansasSec. 23 (Blk. Twp.) 19 (Sur. Rge.) 2W Map No.Operator C R AWell No. 6 Farm KnudsonElev. Location NW SW SE990 Ft. From S Line SE330 Ft. From W Line Quarter1st. Report JAN 10 1951


Completion

Remarks

Spudding Date

Drlg. Data Rich PoolM I R

J. E. TYRA

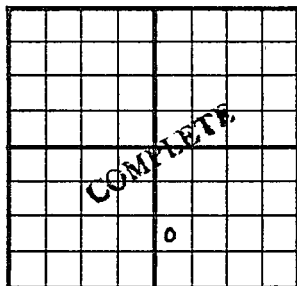County McPherson State KansasSec. 23 (Blk.  
Twp.) 19 (Sur.  
Rge.) 2W Map No.Operator C R AWell No. 6 Farm KnudsonElev. 1550 Location NW SW SE990 Ft. From S Line SE330 Ft. From W Line Quarter1st. ReportCompletion FEB 7 1951Remarks Rich PoolSpudding Date 1-10-51Drlg. Data Oil well TD 296010" @ 124 Lans. 2300 Miss. 2901-487" @ 2927 FU 300' Mud & gassy oilTD 2960 Comp. 40 bopd

J. E. TYRA