

23


19

2W

SECTION _____ TOWNSHIP _____ RANGE _____

WELL NO. #6 B. H. Russell

COMPANY Frank Jones

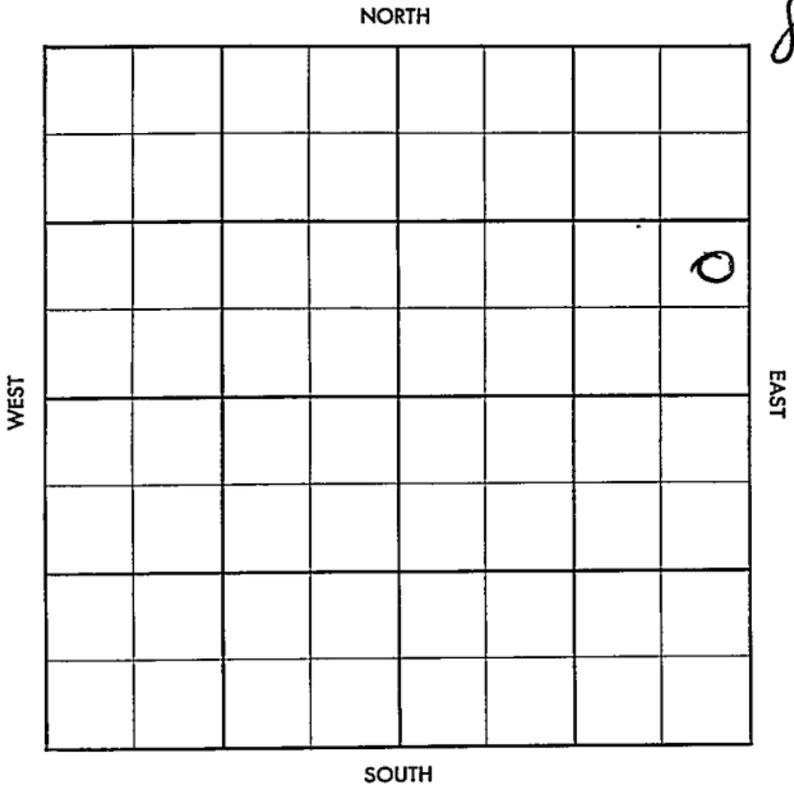


SEC. 23	TWP. 19	R. 2W
------------	------------	----------

WELL NO. #6 B.H. Russell FARM

COMPANY Frank Jones

CONTRACTOR Ritz-Canton

_____ Ft. from N. Line
 _____ Ft. from S. Line
 _____ Ft. from E. Line
 _____ Ft. from W. Line

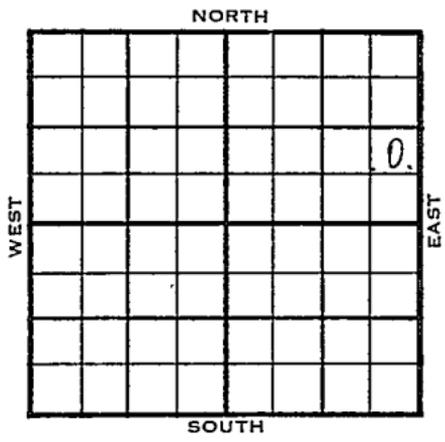

NE SE NE

1956	ELEVATION 1561'	REPORT
------	--------------------	--------

4-25 Location
 5-23 Comm. 4-29-56
 8 5/8" @ 155 w/90
 5 1/2" @ 2944 w/75
 DD 2968'
 S/ 1 BO / 4 BWPH, no inc.
 P/ 25 BO / 125 BWPD
 KG 2309', M. 2912'.
 TD 2948'

COMPLETED

County McPherson Elev. 1561
 Sec. 23 Twp. 19 Rge. 2W
 Company Frank Jones
 Farm Name B. H. Russell No. 6

TOPS	DEPTH	LOG	DATUM	Loc. in Sec.
Anh.				NE SE NE
Tp.				
H.				
Tr.				
Dg.				
Bl.				
L.				Geol.
K.C.	<u>2309</u>			Contr.
B.K.C.				
Ce.				
C.				
M.	<u>2912</u>			Pool
M.				<u>Ritz-Canton</u>
K.				
Mz.				
Mo.				
V.				
S.				
S.				
A.				
R.				
Pe.				
G.				
TD.	<u>2948</u>			

COMPLETE

MAY 3 1956

Date Comm.

Location MAY 2 '56 4-29-56

8 5/8 155/90 TD 1325 MAY 9 '56

5 1/2 @ 2944/75 MAY 15 '56 C6 DD 2968

TD \$ 1 B0 + 4 BWph M.

no ind. MAY 23 '56 P. 25 B0 +

125 BWpd.