



Mc Pherson

Form 252-A  
5M 4-32 MPC

Map No. KANSAS Sec. 23 Twp 19 R. 2W

Well No. 6 W. W. Russell "B" Farm


Helmerick & Payne Company

990 Ft. from N. Line

\_\_\_\_\_ Ft. from S. Line

990 Ft. from E. Line

\_\_\_\_\_ Ft. from W. Line

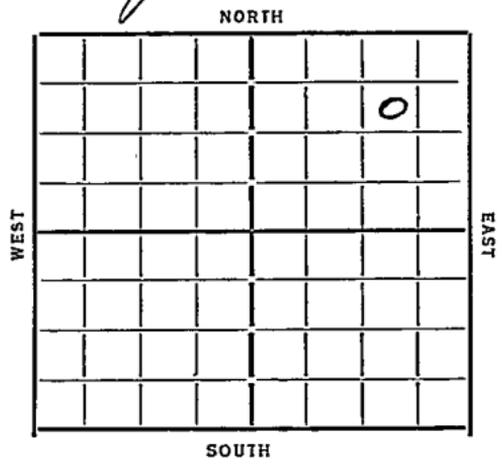

Date 1924

REPORT

5/2 Location

5/10 Rig Rotary

5/18 Rigger up & 55

5/25 ddy 1540

5/31 Top chat 2910 ddy 3023

6/7 Top Viola 3380 Cum 6"  
3380 w.o.c.

6/14 Rust

6/21 — 6/28 —

7/5 Biding

7/12 TD 3385 1000 acid Testing

7/19 —

7/25 Viola 3380 TD 3385  
1000 acid 85 oil 50 water

COMPLETED

*Macpherson*

**KANSAS**

Map No. 43 Sec. 23 Twp. 19 R. 2W

Well No. 6 N. W. Russell (B)

Helmerick & Payne Company

Contractor

**SECTION PLAT**

			0
.			

990 Ft. from N. Line

\_\_\_\_\_ Ft. from S. Line

990 Ft. from E. Line

\_\_\_\_\_ Ft. from W. Line

**FIRST REPORTS**

Location ✓

Rig up \_\_\_\_\_

Drilling and Remarks:

**RECORD**

Cased \_\_\_\_\_ in., \_\_\_\_\_ ft.

Sand \_\_\_\_\_

Gas \_\_\_\_\_

Oil \_\_\_\_\_

Total Depth \_\_\_\_\_

**PRODUCTION**

1st 24 hrs. Nat. \_\_\_\_\_

1st 24 hrs. after shot \_\_\_\_\_

Gas \_\_\_\_\_ Cu. Ft.

Dry Hole \_\_\_\_\_

Abandoned \_\_\_\_\_

Date

5-23-19

**ORVAL MANN SCHRECK**

Scout

Map No. 43 Sec. 23 Twp. 19 R. 2W

Well No. 6-N.W. Russell 'B'

Helmick & Payne Company  
Contractor

**COMPLETED**

**SECTION PLAT**

			0

990 Ft. from N. Line

\_\_\_\_\_ Ft. from S. Line

990 Ft. from E. Line

\_\_\_\_\_ Ft. from W. Line

Location \_\_\_\_\_

Rig up \_\_\_\_\_

Drilling and Remarks:

1000 acid

85 oil  
50 water

**RECORD**

Cased \_\_\_\_\_ in., \_\_\_\_\_ ft.

Sand Viola 3380

Gas \_\_\_\_\_

Oil \_\_\_\_\_

Total Depth 3385

**PRODUCTION**

1st 24 hrs. Nat. \_\_\_\_\_

1st 24 hrs. after shot \_\_\_\_\_

Gas \_\_\_\_\_ Cu. Ft.

Dry Hole \_\_\_\_\_

Abandoned \_\_\_\_\_

Date

7-25-34 19

**ORVAL MANNSCHRECK**

Scout