


McPherson

Form 51-5M-11-31-Palace

Map No. **KANSAS** Sec. *23* Twp. *19* R. *2W*

Well No. *3 Finkle* Farm
Shell Pet. Company

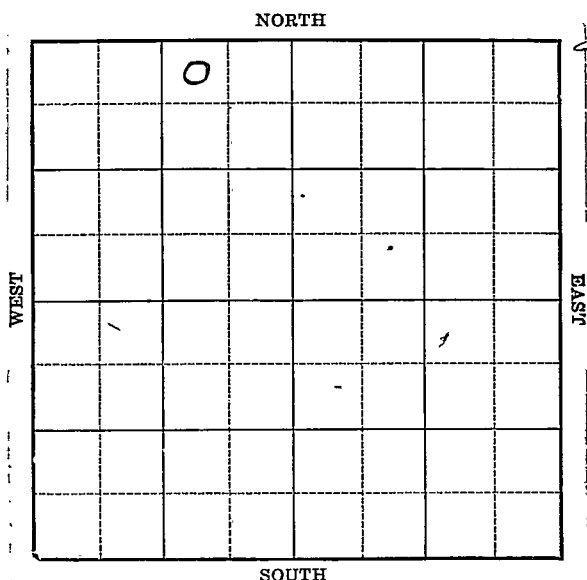

Location _____

Drilling Remarks _____

Rig Up _____

Drilling Remarks _____

RECORD

Cased _____ in. _____ ft.

Sand _____

Gas _____

Oil _____

Total Depth _____

PRODUCTION

1st 24 hrs. Nat. _____

1st 24 hrs. after shot _____

Gas _____ cu. ft.

Dry Hole _____

Abandoned _____

Mc Pherson


Map No. **KANSAS** Sec. 23 Twp. 19 R. 2 W
 Well No. 3 Finkle Farm
Shell Pet Company

330 Ft. from N. Line

Ft. from S. Line

999 Ft. from E. Line

Ft. from W. Line

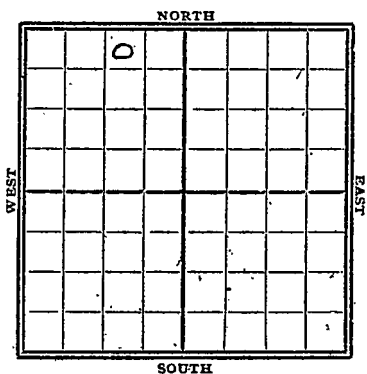Date
1934

REPORT

4/4 Moving in
 4/12 dly 560 12" 151
 4/19 " 1535
 4/26 " 3052 chst 2899
 5/3 B. L. 3121 7" 3369 Rust
 5/10 T D 3383 Swab 4 Bbls
 oil per hr 10% water
 5/18 1000 Hal acid No test
 5/25 167 oil + 60 H. 16 hrs.
 5/31 Pump 112 oil 102 water
 6/7 —
 6/13 T D 3383 1000 acid
 112 oil 102 water

COMPLETED

KANSAS

Map No. 43 Sec. 23 Twp. 19 R. 2W

Well No. 3-4' in the

Company

FIRST REPORT

Contractor

SECTION PLAT

330 Ft. from N. Line

Ft. from S. Line

999 Ft. from E. Line

Ft. from W. Line

	0		

Location_____

Rig up_____

Drilling and Remarks:

Moving in

RECORD

Cased _____ in. _____ ft.

Sand _____

Gas _____

Oil _____

Total Depth

PRODUCTION

1st 24 hrs. Nat. Feb 20

1st 24 hrs. after shot.

Gas per 100 cu. ft. Cu. Ft.

Dry Hole _____

Abandoned

Date _____

Date 4-4-34 19

O. Manachuk Scout

Map No. McClure Sec. 23 Twp. 19 R. 2WWell No. 3-FrinkleShell pit Company _____

Contractor _____



SECTION PLAT

	0		
1			

330 Ft. from N. Line

_____ Ft. from S. Line

999 Ft. from E. Line

_____ Ft. from W. Line

Location _____

Rig up _____

Drilling and Remarks:

1000 and112 oil
102 water

RECORD

Cased _____ in., _____ ft.

Sand _____

Gas _____

Oil _____

Total Depth 3383

PRODUCTION

1st 24 hrs. Nat. _____

1st 24 hrs. after shot _____

Gas _____ Cu. Ft.

Dry Hole _____

Abandoned _____

Date

6-13-31₁₉

ORVAL MANNSCHRECK

Scout