

Map No. **KANSAS** Sec. **23** Twp. **19** R. **24**

Well No. 4-C Russell Farm  
Helmreich & Payne Company

NORTH

WEST

## EAST

SOUTH

Location\_\_\_\_\_

### Drilling Remarks

Rig Up\_\_\_\_\_

### Drilling Remarks

## RECORD

Cased\_\_\_\_\_in. \_\_\_\_\_ft.

Sand\_\_\_\_\_

# Gas

# Oil

Total Depth \_\_\_\_\_

## PRODUCTION

1st 24 hrs. Nat.-----

1st. 24 hrs. after shot-----

Gas \_\_\_\_\_ cu. ft. \_\_\_\_\_

Dry Hole.....

## Abandoned

McPherson

Map No. **KANSAS** Sec. 23 Twp 19 R. 2W

Well No. 4-C Russell Farm


Helmreich & Payne Company

           Ft. from N. Line

990 Ft. from S. Line

           Ft. from E. Line

990 Ft. from W. Line

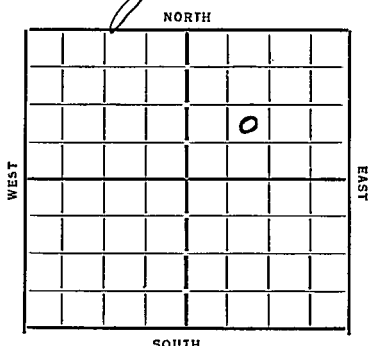

Date 1934

REPORT

|       |                           |
|-------|---------------------------|
| 5/23  | Rig                       |
| 5/31  | — 6/7 — 6/14 —            |
| 6/21  | — 6/28 — 7/5 —            |
| 7/12  | — 7/19 — 7/26 —           |
| 8/2   | — 8/9 —                   |
| 8/16  | Dlg 545                   |
| 8/23  | " 2750                    |
| 8/30  | Top Chst 2914             |
| 9/6   | Viola 3373 Rust           |
| 9/13  | Bailing                   |
| 9/20  | Dlg cement                |
| 9/27  | T 3385 25' oil Acidizing  |
| 10/4  | Testing                   |
| 10/11 | — 10/18 —                 |
| 10/25 | Est 100 Bbl well.         |
| 11/1  | — 11/8 —                  |
| 11/17 | Viola 3373 T 3388         |
|       | 1000 acid 25 oil 25 water |

COMPLETED

Wichita KANSAS

Map No. 43 Sec. 23 Twp. 19 R. 2WWell No. 4-C - Russell  
Helmerick & Payne Company  
Contractor

## FIRST REPORTS

\_\_\_\_ Ft. from N. Line

990 Ft. from S. Line

\_\_\_\_ Ft. from E. Line

990 Ft. from W. Line

## SECTION PLAT

|   |  |   |  |
|---|--|---|--|
|   |  |   |  |
| 1 |  | 0 |  |
|   |  |   |  |
|   |  |   |  |

Location \_\_\_\_\_

Rig up \_\_\_\_\_

Drilling and Remarks:

Fig1/2

## RECORD

Cased \_\_\_\_\_ in., \_\_\_\_\_ ft.

Sand \_\_\_\_\_

Gas \_\_\_\_\_

Oil \_\_\_\_\_

Total Depth \_\_\_\_\_

## PRODUCTION

1st 24 hrs. Nat. \_\_\_\_\_

1st 24 hrs. after shot \_\_\_\_\_

Gas \_\_\_\_\_ Cu. Ft.

Dry Hole \_\_\_\_\_

Abandoned \_\_\_\_\_

Date

5-23-34

ORVAL MANNSCHRECK

Scout

Form 28 - 1M Bk. - 3-28  
*Dr. Jefferson*

KANSAS

Map No. *43* Sec. *23* Twp. *19* R. *2W*

Well No. *4C - Russell*

*Helmerick & Payne* Company

Contractor

COMPLETED

SECTION PLAT

Ft. from N. Line

*990* Ft. from S. Line

Ft. from E. Line

*990* Ft. from W. Line

|  |  |   |  |
|--|--|---|--|
|  |  |   |  |
|  |  | 0 |  |
|  |  |   |  |
|  |  |   |  |

Location

Rig up

Drilling and Remarks:

*1000 acid*

*25 oil*  
*25 water*

RECORD

Cased in, ft.

Sand *Viola* *3373*

Gas

Oil

Total Depth *3388*

PRODUCTION

1st 24 hrs. Nat.

1st 24 hrs. after shot

Gas Cu. Ft.

Dry Hole

Abandoned

Date

*11-17-34* 192

ORVAL MANNSCHRECK  
Scout