



McPherson

Form 252-A  
5M 4-32 MPC

KANSAS

Map No. \_\_\_\_\_ Sec. 23 Twp. 19 R. 2W

Well No. 3-Hill Farm

Miller

Laruo - & - Shell Company


NORTH

\_\_\_\_\_ Ft. from N. Line

330 Ft. from S. Line

990 Ft. from E. Line

\_\_\_\_\_ Ft. from W. Line

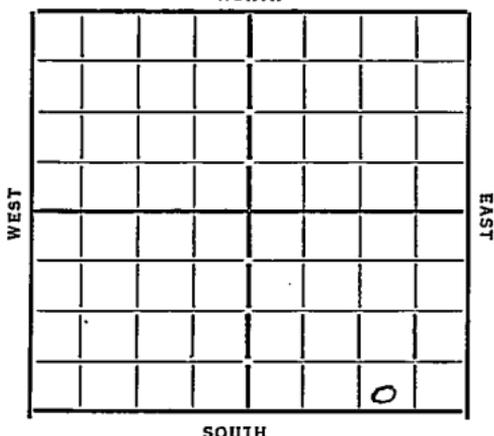

REPORT

Date

1933

7/26 location

8/2 \_\_\_\_\_

8/19 \_\_\_\_\_

8/17 \_\_\_\_\_

8/23 \_\_\_\_\_

8/30 \_\_\_\_\_

9/6 Viola 3338 T.D. 3411

480 bbls

COMPLETED

10/18 Arleg 2070

10/25 " 2510

11/1 Top Chat 2915 2965 S.D.

11/8 Arleg 3095

11/15 Base Miss 3128

Top Viola 3375 - Set 5"

11/22 Treated with 1000 gal acid

11/29 Pump 94 bbls in 5 hrs

12/6 Viola 3375 T.D. 3391

Pot 290 bbls

COMPLETED

Map No. 43 Sec. 23 Twp. 19 R. 2W

Well No. 3-Hill

Parist Shell Company

Contractor

SECTION PLAT

Ft. from N. Line

330 Ft. from S. Line

990 Ft. from E. Line

Ft. from W. Line

			0

**FIRST REPORTS**

Location

Rig up

Drilling and Remarks:

RECORD

Cased.....in., .....ft.

Sand.....

Gas.....

Oil.....

Total Depth.....

PRODUCTION

1st 24 hrs. Nat.....

1st 24 hrs. after shot.....

Gas.....Cu. Ft.

Dry Hole.....

Abandoned.....

Date

7/26/33 O. Manschreck Scott

Map No. 43 Sec. 23 Twp. 19 R. 2W

Well No. 3-Hill

Lario & Shell Company

Contractor

**COMPLETED**

**SECTION PLAT**

.....Ft. from N. Line

230 Ft. from S. Line

990 Ft. from E. Line

.....Ft. from W. Line

			0

Location.....

Rig up.....

Drilling and Remarks:

*pot.*  
*290 lbs*

**RECORD**

Cased.....in.....ft.

Sand Viola 3375

Gas.....

Oil.....

Total Depth 3391

**PRODUCTION**

1st 24 hrs. Nat.....

1st 24 hrs. after shot.....

Gas.....Cu. Ft.

Dry Hole.....

Abandoned.....

Date

15-6-33 192

O. Marnschke Scout