


Mc Pherson

Form 51-5M-11-31-Palace

Map No. **KANSAS** Sec. **23** Twp. **19** R. **2W**

Well No. **4 Knudson** Farm

Apex Oil Company

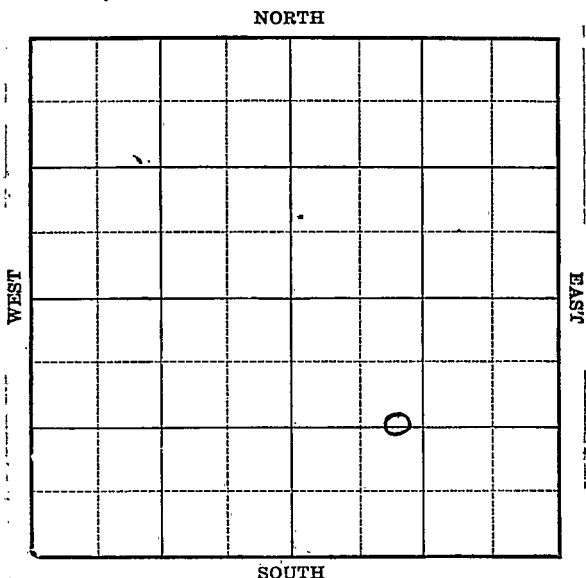

Location

Drilling Remarks

Rig Up

Drilling Remarks

RECORD

Cased in. ft.

Sand

Gas

Oil

Total Depth

PRODUCTION

1st 24 hrs. Nat.

1st 24 hrs. after shot

Gas cu. ft.

Dry Hole

Abandoned

Mc Pherson

Map No. **KANSAS** Sec. **23** Twp. **19** R. **2W**

Well No. **4 Knudson** Farm


Apex Oil Company

Ft. from N. Line

1320 Ft. from S. Line

Ft. from E. Line

990 Ft. from W. Line

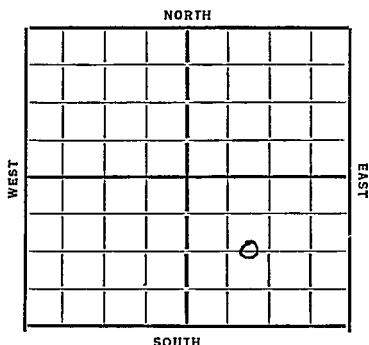

Date
1934

REPORT

2/7	Rot. Rig
2/14	— 2/23 — 3/1 —
3/9	— 3/15 — 3/22 —
3/29	— 4/5 — 4/12 —
4/19	— 4/26 — 5/3 —
5/10	12" cum. 115
5/18	— 5/25 —
5/31	dog 800
6/7	" 2450
6/14	Chat 2910 8" 2910 WOC
6/31	—
6/28	Rust
7/5	—
7/11	Chat 2910 TD 2954
	85 oil 10 water

COMPLETED

Map No. 43 Sec. 23 Twp. 19 R. 2WWell No. 4 - KnudsenOpen Oil Company

Contractor

FIRST REPORTS

Ft. from N. Line

1320 Ft. from S. Line

Ft. from E. Line

990 Ft. from W. Line

SECTION PLAT

2			
		0	

Location

Rig up

Drilling and Remarks:

Rot Rig

RECORD

Cased.....in.,ft.

Sand.....

Gas.....

Oil.....

Total Depth.....

PRODUCTION

1st 24 hrs. Nat.....

1st 24 hrs. after shot.....

Gas.....Cu. Ft.

Dry Hole.....

Abandoned.....

Date

2-7-34 192 O. Mannes Scout

McPherson

Map No. 43 Sec. 23 Twp. 19 R. 2W

Well No. 4 - Knudsen

Apex oil Company

Contractor

COMPLETED

SECTION PLAT

		0	

_____ Ft. from N. Line

1320 Ft. from S. Line

_____ Ft. from E. Line

990 Ft. from W. Line

COMPLETED

Location _____

Rig up _____

Drilling and Remarks:

85 oil
10 water

RECORD

Cased _____ in., _____ ft.

Sand Chat 2910

Gas _____

Oil _____

Total Depth 2954

PRODUCTION

1st 24 hrs. Nat. _____

1st 24 hrs. after shot _____

Gas _____ Cu. Ft.

Dry Hole _____

Abandoned _____

Date

7-11-34 19

CRYAL MANN SCRECK

Scout