

McPherson


Form 51-5M-11-31-SPalace

Map No. **KANSAS** Sec. *23* Twp. *19* R. *2W*

Well No. *3-Knudsen* Farm

Apex Oil Company

NORTH

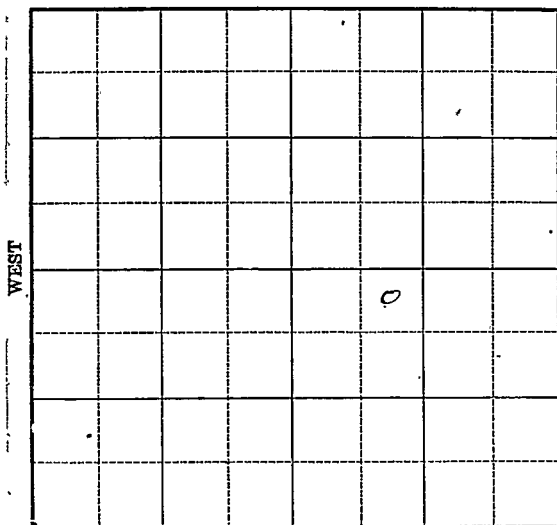

SOUTH

Location

Drilling Remarks

Rig Up

Drilling Remarks

RECORD

Cased _____ in. _____ ft.

Sand _____

Gas _____

Oil _____

Total Depth _____

PRODUCTION

1st 24 hrs. Nat. _____

1st 24 hrs. after shot _____

Gas _____ cu. ft.

Dry Hole _____

Abandoned _____


Well No. 3 Kneudrew Farm

330' Ft. from N. Line

Ft. from S. Line

Ft. from E. Line

990' Ft. from W. Line

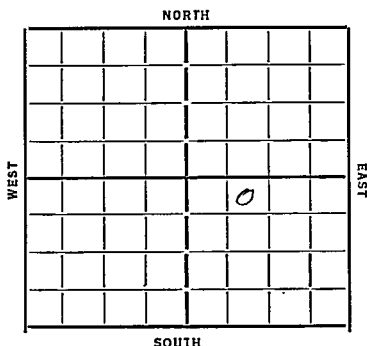

Date 14/3/23

REPORT

12/27 Location

411 Rig

1/17	Spud
------	------

1/24 Top chat 2940

Wreg 2950

1/31 B. Miss L 3120 TD 3358 Coring
2" 3360 1100

2/7 8" 3368 WOC

2/14	Rush.
------	-------

2/23	Viola 3371 TO 3393 400' fluid
------	-------------------------------

3/1	95 3376 Pump 192 Bkls
-----	-----------------------

24 hrs. acidizing

2/7 Viola 3371 95 3376

1000 Gal acid Pump 192

Bkls 24 hrs.

COMPLETED

Map No. 43 Sec. 23 Twp. 19 R. 2W

Well No. 3-Knudsen

Apex Oil Company

Contractor

FIRST REPORTS

SECTION PLAT

330 Ft. from N. Line

..... Ft. from S. Line

..... Ft. from E. Line

990 Ft. from W. Line

		0	

Location ☒

Rig up

Drilling and Remarks:

RECORD

Cased.....in.,ft.

Sand.....

Gas.....

Oil.....

Total Depth.....

PRODUCTION

1st 24 hrs. Nat.....

1st 24 hrs. after shot.....

Gas.....Cu. Ft.

Dry Hole.....

Abandoned.....

Date

12-27-33 192 O. Manscheck Scout

Map No. 43 Sec. 23 Twp. 19 R. 2W

Well No. 3-11 nadsen

Apex Oil Company

Contractor

COMPLETED

SECTION PLAT

330 Ft. from N. Line

..... Ft. from S. Line

..... Ft. from E. Line

990 Ft. from W. Line

		0	

Location.....

Rig up.....

Drilling and Remarks:

1000 gal and

Pump

192

24 hrs

RECORD

Cased..... in., ft.

Sand Viola 3371

Gas.....

Oil.....

Total Depth 3376

PRODUCTION

1st 24 hrs. Nat.....

1st 24 hrs. after shot.....

Gas..... Cu. Ft.

Dry Hole.....

Abandoned.....

Date

3-7-34 192

O. Mannschreck Scout