


McPherson

Form 51-5M-11-31-Palace

Map No. **KANSAS** Sec. *23* Twp. *19* R. *2 W*
Well No. *2 Knudsen* Farm
Apex Oil Company

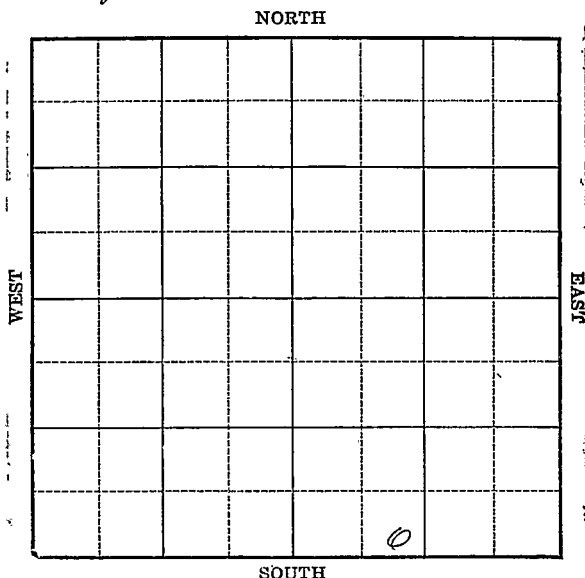

Location _____

Drilling Remarks _____

Rig Up _____

Drilling Remarks _____

RECORD

Cased _____ in. _____ ft.

Sand _____

Gas _____

Oil _____

Total Depth _____

PRODUCTION

1st 24 hrs. Nat. _____

1st 24 hrs. after shot _____

Gas _____ cu. ft.

Dry Hole _____

Abandoned _____

McPherson

Form 252-A
5M 4-32 MPC

Map No. KANSAS Sec. 23 Twp. 19 R. 2W


Well No. #2 Knudsen Farm
Alex Oil Company

 Ft. from N. Line

330 Ft. from S. Line

 Ft. from E. Line

990 Ft. from W. Line

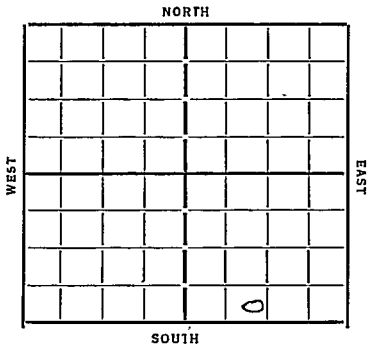

Date
1933

REPORT

9/6 location
9/13 Pond
9/20 9/29
10/5 Rig in
10/11 12" at 116 - Hrlg 610
10/18 Hrlg 2180
10/25 20p chat 2918 - 8" at 2918 - S.D
11/1
11/8 Hrlg 3045
11/15 Base Miss 3145
 Top Viola 3374
 cem 5" at 3375
11/22 R.H.S.T.
11/29
12/6 T.D. 3380. Treated w/ 1000 gal acid
12/12 pump 90 oil + 5 water 9 hrs
 1000 gal acid
12/20 Viola 3374 TD. 3380'
 465 bbl oil
 30% water
 COMPLETED

Map No. 43 Sec. 23 Twp. 19 R. 2W

Well No. #2 - Knudsen

Apex Oil Company

Contractor

SE SW SE SECTION PLAT

Ft. from N. Line

330 Ft. from S. Line

Ft. from E. Line

990 Ft. from W. Line

FIRST REPORTS

Location ✓

Rig up

Drilling and Remarks:

RECORD

Cased in., ft.

Sand

Gas

Oil

Total Depth

PRODUCTION

1st 24-hrs. Nat.

1st 24 hrs. after shot

Gas Cu. Ft.

Dry Hole

Abandoned

Date

9/6/33 192 O. Mannschuet Secut

Map No. 43 Sec. 23 Twp. 19 R. 2WWell No. 2-KnudsenApex Oil Company

Contractor

COMPLETED

SECTION PLAT

Ft. from N. Line

330 Ft. from S. Line

Ft. from E. Line

990 Ft. from W. Line

Location.....

Rig up.....

Drilling and Remarks:

465 oil
3% w

RECORD

Cased.....in.,.....ft.

Sand Viola 3374

Gas.....

Oil.....

Total Depth 3380

PRODUCTION

1st 24 hrs. Nat.....

1st 24 hrs. after shot.....

Gas.....Cu. Ft.

Dry Hole.....

Abandoned.....

Date

12-20-33 192 O. Mannschuck Scout