


M^o Pherson

Form 51-5M-2-29-34703

Map No. KANSAS Sec. 23 Twp. 19 R. 2^w

Well No. 1- Knudson Farm
Rosenthal et al Company

NORTH

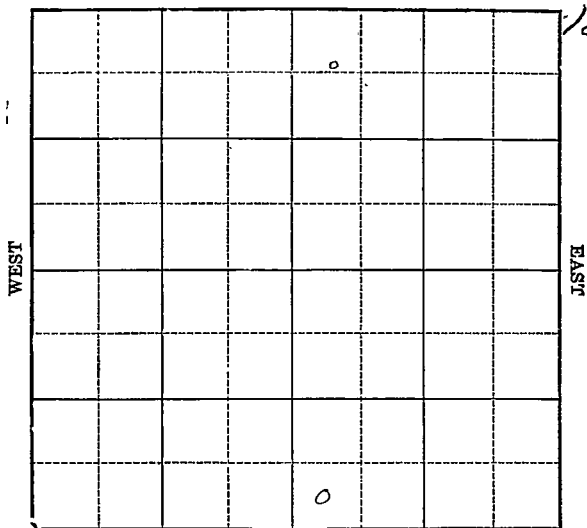

SOUTH

OWDD

Location _____
Drilling Remarks _____

Rig Up _____
Drilling Remarks _____

RECORD

Cased _____ in. _____ ft.
Sand _____
Gas _____
Oil _____
Total Depth _____

PRODUCTION

1st 24 hrs. Nat. _____
1st 24 hrs. after shot _____
Gas _____ cu. ft.
Dry Hole _____
Abandoned _____

Map No. KANSAS Sec. 23 Twp. 19 R. 2^w
Well No. 1- Snudson Farm
Rosenthal et al Company

NORTH


_____ Ft. from N. Line

330 Ft. from S. Line

_____ Ft. from E. Line

330 Ft. from W. Line

1931

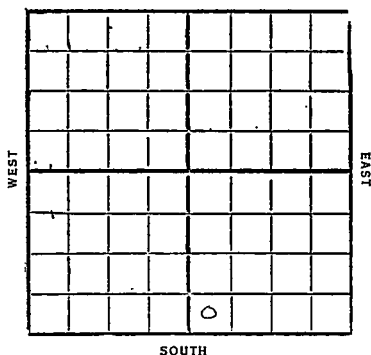

Date

REPORT

4/22	Pos.
4/29	Big
5/6	Run up
5/13	
5/20	Drilg 710'
5/27	" 1480'
6/3	" 2035'
6/10	10"-2248
	Drilg 2310'
6/17	HW 2420
	Drilg 2430'
6/24	SD 2430' repairs
7/1	
7/8	Drilg. 2510'
7/15	8"-2432
	TD 2912 U11R 8"
7/22	set 8"-2913' Olg out
7/29	TD 2916' Cem 8"
8/5	T.D. 2916' Blow in
	for 6 1/4 ft gas
	after drilg cement
	(over)

8/12 Chat 2916-30

T.D. 2930

8 3/4 M gas

Comp.

1931 OWDD

9/9 Old T.D. 2930

drilled to

T.D. 2964

Increase at 2952

Est 9 1/2 M gas

and 17 bbl oil hour

9/16- T.D. 2964

No test

9/23 —

9/30 —

10/7 Top Chat 2916

Old T.D. 2930

deepened to

T.D. 2964

8 1/2 M gas

1933 — Comp.

5/10 Q.O. 10, 10, 10,

Old T.D. 2964, Only 3020 Lpm

5/17 - 8" 2945 B.L. 3135 Only 3235

5/24 Casing trouble 3240'

6/1 Casing 6" 3244 T.D. 3270 - Q.O.

6/8 Top Viola 3378 show oil 3379-80 Q.O.

6/15 T.D. 3381 acidize on 9th 1000 gal 70 test

6/21 - 255 bbls oil 98 bbls water 24 hrs

6/28 - Top Viola 3378

T.D. 3381

255 bbls oil 100 bbls water

COMPLETED

McPherson
 43 **KANSAS** Sec. *23* Twp. *19* R. *2* ^W
 Well No. *1* *McPherson*
Rosenthal et al Company

Contractor

FIRST REPORTS

Ft. from N. Line

330 Ft. from S. Line

Ft. from E. Line

330 Ft. from W. Line

SECTION PLAT

Location *Ro y.*

Rig up

Drilling and Remarks:

RECORD

Cased.....in.,ft.

Sand.....

Gas.....

Oil.....

Total Depth.....

PRODUCTION

1st 24 hrs. Nat.....

1st 24 hrs. after shot.....

Gas.....Cu. Ft.

Dry Hole.....

Abandoned.....

Date

APR 22 1931

192

CHAS. L. SHERWOOD

Scout

James
W. W. W.

Returned	<i>W. W. W.</i>
Cards	
Tracing	<i>W. W. W.</i>
France Map	X
Scarborough Map	<i>W. W. W.</i>
Moody Map	X
Scarborough Plat Book	
Moody Plat Book	

Map No. KANSAS Sec. 23 Twp. 19 R. 2 ^W
 Well No. 43 1 Kmussow
Rosenthal & al Company

Contractor

COMPLETE

SECTION PLAT

Ft. from N. Line

330 Ft. from S. Line

Ft. from E. Line

330 Ft. from W. Line

Location

Rig up

Drilling and Remarks:

RECORD

Cased _____ in. _____ ft.
 Sand Char 2916-2930
 Gas _____
 Oil _____
 Total Depth: 2930

PRODUCTION

1st 24 hrs. Nat. _____
 1st 24 hrs. after shot _____
 Gas 8 3/4 14 Cu. Ft.
 Dry Hole _____
 Abandoned _____

Date

AUG 12 1931 CHAS. L. SHERWOOD
 192 _____ Scout

Journal of
W. W. Moody

Returned	<i>W. W. Moody</i>
Cards	<i>W. W. Moody</i>
Tracing	<i>W. W. Moody</i>
France Map	<i>W. W. Moody</i>
Scarborough Map	<i>W. W. Moody</i>
Moody Map	<i>W. W. Moody</i>
Scarborough Plat Book	<i>W. W. Moody</i>
Moody Plat Book	<i>W. W. Moody</i>

43 *McPherson*
 Map No. **KANSAS** Sec. *23* Twp. *19* R. *2*^W
 Well No. *1* *Knudson*
Rosenthal & Co. Company

Contractor

FIRST REPORTS


Ft. from N. Line

330 Ft. from S. Line

Ft. from E. Line

330 Ft. from W. Line*"O.W.D.D."*

SECTION PLAT

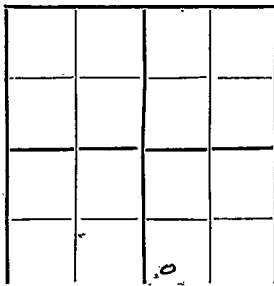

Location

Rig up *O.W.D.D. 2930*

Drilling and Remarks:

*Deepened to 2944
 increase at 2952
 lost 9 1/2 cu. Gas.
 and 17 lbs Oil per
 hour.*

RECORD

Cased _____ in., _____ ft.

Sand _____

Gas _____

Oil _____

Total Depth _____

PRODUCTION

1st 24 hrs. Nat. _____

1st 24 hrs. after shot _____

Gas _____ Cu. Ft.

Dry Hole _____

Abandoned _____

Date

SEP 9 1931

CHAS. L. SHERWOOD

Scout

W. A. J. S.

Returned	
Cards	
Tracing	
France Map	
Scarborough Map	
Moody Map	
Scarborough Plat Book	
Moody Plat Book	

43 KANSAS

Map No. _____ Sec. 23 Twp. 19 R. 2 W

Well No. 1 Knudson

Rosenthal & Co Company

Contractor

COMPLETED

_____ Ft. from N. Line

330 Ft. from S. Line

_____ Ft. from E. Line

330 Ft. from W. Line

"DW D"

SECTION PLAT

Location _____

Rig up _____

Drilling and Remarks:

Old ID 2930
Deepened to 2964

RECORD

Cased _____ in _____ ft.

Sand Chat 2916'

Gas _____

Oil _____

Total Depth 2964

PRODUCTION

1st 24 hrs. Nat. _____

1st 24 hrs. after shot _____

Gas 8 1/2 M Cu. Ft.

Dry Hole _____

Abandoned _____


Date

OCT 7 1931

CHAS. L. SHERWOOD

192

Scout

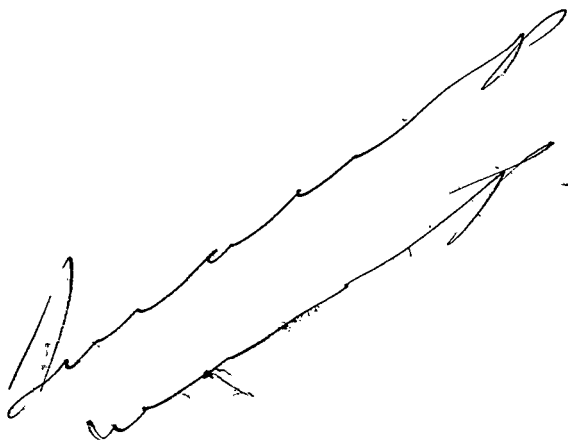

Returned	<i>[Signature]</i>
Cards	<i>[Signature]</i>
Tracing	<i>[Signature]</i>
France Map	<i>[Signature]</i>
Scarborough Map	<i>[Signature]</i>
Moody Map	<i>[Signature]</i>
Scarborough Plat Book	<i>[Signature]</i>
Moody Plat Book	<i>[Signature]</i>

McPherson

43

KANSAS

Map No. _____ Sec. 23 Twp. 19 R. 2

Well No. 1 Knudson

Rosenthal & Co. Company

Contractor

FIRST REPORTS

Ft. from N. Line

330 Ft. from S. Line

Ft. from E. Line

330 Ft. from W. Line

SECTION PLAT

	"OVD"		

Location _____

Rig up _____

Drilling and Remarks: old

Old 3020'
in line

RECORD

Cased ☒ in, _____ ft.Sand ☒ Top Chas 2916

Gas _____

Oil _____

Total Depth 2964

PRODUCTION

1st 24 hrs. Nat. _____

1st 24 hrs. after shot _____

Gas _____ Cu. Ft.

Dry Hole _____

Abandoned _____

Date

MAY 1 0 1933

192

CHAS. L. SHERWOOD

Scout

[Handwritten scribbles and lines]

Returned	
Cards	<i>MPB</i>
Tracing	<i>CRH</i>
France Map	<i>[initials]</i>
Scarborough Map	<i>[initials]</i>
Moody Map	<i>[initials]</i>
Scarborough Plat Book	
Moody Plat Book	

Meyerson


Map No. Sec. 23 Twp. 19 R. 2W

Well No. 1-Knudson

Rosenthal Ital Company

Contractor

SECTION PLAT

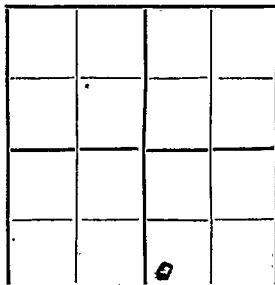

Ft. from N. Line

330 Ft. from S. Line

Ft. from E. Line

330 Ft. from W. Line

COMPLETED

Location

Rig up

Drilling and Remarks:

viola 3378

255 oil
100 bbls water

RECORD

Cased in., ft.

Sand

Gas

Oil

Total Depth 3381

PRODUCTION

1st 24 hrs. Nat.

1st 24 hrs. after shot

Gas Cu. Ft.

Dry Hole

Abandoned

Date

6/28/33 192 Orval Mannschuh Scout

Returned _____
Cards _____
Tracing *CS* _____
France Map _____
Scarborough Map _____
Moody Map _____
Scarborough Plat Book _____
Moody Plat Book _____