

Mc Pherson

Map No. KANSAS Sec. 23 Twp. 19 R. 2^w


Well No. 5 Hill Farm
Lario & Shell Company

_____ Ft. from N. Line

1320 Ft. from S. Line

990 Ft. from E. Line

_____ Ft. from W. Line

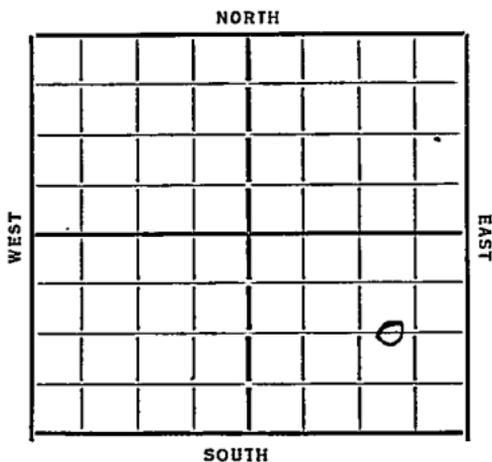

Date
1934

REPORT

2/7 Rig

2/14 ↓

2/23 15" 121 760.C.

3/11 Fishy 2150

3/18 Duly 2988 Chat 2926

3/15 Base Miss 3110 8" 3377
Rust

3/22 Viola 3379 75 3386 No test

4/4 Wilcox 3424 TD 3427
1000 Gal acid Pump
225 oil + 75 water

COMPLETED

Form 26 - 1M Bks - 229
McPherson

Map No. 43 Sec. 23 Twp. 19 R. 2W

Well No. 5-Hill

Louis & Shell Company

Contractor

COMPLETED

SECTION PLAT

_____ Ft. from N. Line

1320 Ft. from S. Line

990 Ft. from E. Line

_____ Ft. from W. Line

Location _____

Rig up _____

Drilling and Remarks:

1000 gal acid

*pump 225 oil
25 water*

RECORD

Cased _____ in., _____ ft.

Sand Wilcox 3424

Gas _____

Oil _____

Total Depth 3427

PRODUCTION

1st 24 hrs. Nat. _____

1st 24 hrs. after shot _____

Gas _____ Cu. Ft.

Dry Hole _____

Abandoned _____

Date

4-4-34 19 O. M. Mansch Sec

Form 26-1M Bks-9-28
Mapleson

Map No. 43 Sec. 23 Twp. 19 R. 2W

Well No. 5-Hill

Lario & Shell Company

Contractor

FIRST REPORTS

SECTION PLAT

..... Ft. from N. Line

1320 Ft. from S. Line

990 Ft. from E. Line

..... Ft. from W. Line

Location.....

Rig up.....

Drilling and Remarks:

Rig

RECORD

Cased.....in.,ft.

Sand.....

Gas.....

Oil.....

Total Depth.....

PRODUCTION

1st 24 hrs. Nat.....

1st 24 hrs. after shot.....

Gas.....Cu. Ft.

Dry Hole.....

Abandoned.....

Date

2-7-34 192

O. Mansbeck
Scout