

W. P. Pherson

Map No. **KANSAS** Sec. *23* Twp *19* R. *2 W*

Well No. *4 Hill* Farm


Lariv Company

330' Ft. from N. Line

_____ Ft. from S. Line

990' Ft. from E. Line

_____ Ft. from W. Line

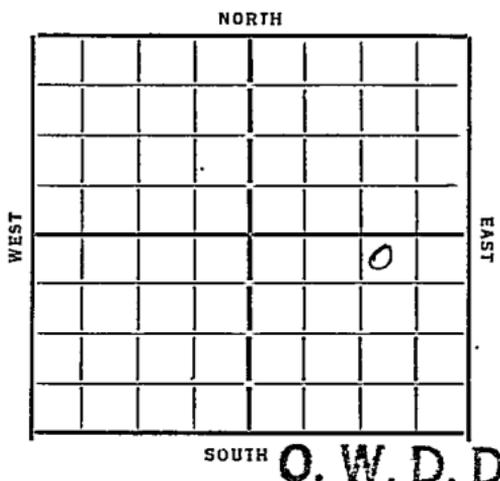

Date *1934*

REPORT

1/3 Cellar
1/11 _____
1/17 material
1/24 Rig
1/31 Drlg 890
2/7 " 2600
2/14 Chut 2919 BL 3135 8" 3369
2/23 _____
3/1 RUST
3/8 Viola 3378 75 3384 CO
3/15 1000 Gal acid No test
3/21 Viola 3378 75 3384 1000 Gal acid 220 Bbls.

COMPLETED

1935

O. W. D. D

3/13 Bas Viola 3416
T Wilcox 3420.
3/20 Wilcox 3420 T 7 3442
20 Bbls.

COMPLETED

McPherson
Map No. 43 Sec. 23 Twp. 19 R. 2W

Well No. H-Hill
Paris Company

Contractor

FIRST REPORTS

SECTION PLAT

330 Ft. from N. Line

..... Ft. from S. Line

990 Ft. from E. Line

..... Ft. from W. Line

			○

Location.....

Rig up.....

Drilling and Remarks:

cellar

RECORD

Cased..... in., ft.

Sand.....

Gas.....

Oil.....

Total Depth.....

PRODUCTION

1st 24 hrs. Nat.....

1st 24 hrs. after shot.....

Gas..... Cu. Fts

Dry Hole.....

Abandoned.....

Date

1-3-34 192 O. Mannschick Sec 26

Map No. 43 Sec. 23 Twp. 19 R. 2W

Well No. 4-Hill

Lario O + H Company

Contractor

COMPLETED

330 Ft. from N. Line

_____ Ft. from S. Line

990 Ft. from E. Line

_____ Ft. from W. Line

SECTION PLAT

			0

Location _____

Rig up _____

Drilling and Remarks:

1000 gal acid

220 bbls

RECORD

Cased _____ in., _____ ft.

Sand Viola 3378

Gas _____

Oil _____

Total Depth 3384

PRODUCTION

1st 24 hrs. Nat. _____

1st 24 hrs. after shot _____

Gas _____ Cu. Ft.

Dry Hole _____

Abandoned _____

Date

3/21/34 1934 O. Manschreck Scout

J. M. Johnson

Map No. 43 Sec. 23 Twp. 19 R. 2W

Well No. 4-Hill

Lario oil Company

Contractor

FIRST REPORTS

330 Ft. from N. Line

..... Ft. from S. Line

990 Ft. from E. Line

..... Ft. from W. Line

OWN

SECTION PLAT

			0

Location.....

Rig up.....

Drilling and Remarks:

OTN 3384
Base Viola 3416
T. Wilcox 3420

RECORD

Cased..... in., ft.

Sand.....

Gas.....

Oil.....

Total Depth.....

PRODUCTION

1st 24 hrs. Nat.....

1st 24 hrs. after shot.....

Gas..... Cu. Ft.

Dry Hole.....

Abandoned.....

Date

3-13-35 192.....

ORVAL MANSCHRECK

Scout

Map No. 43 Sec. 23 Twp. 19 R. 2W

Well No. 4-Hill

Louis oil Company

Contractor

COMPLETED


SECTION PLAT

330 Ft. from N. Line

..... Ft. from S. Line

990 Ft. from E. Line

..... Ft. from W. Line

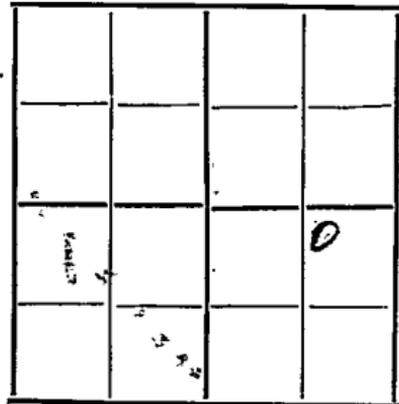

O.P.D.

Location.....

Rig up.....

Drilling and Remarks:

20 ft

RECORD

Cased..... in., ft.

Sand Wiley 3420

Gas.....

Oil.....

Total Depth 3442

PRODUCTION

1st 24 hrs. Nat.....

1st 24 hrs. after shot.....

Gas..... Cu. Ft.

Dry Hole.....

Abandoned.....

Date

3-20-35 192.....

ORVAL MANSCHRECK

Scout