

Mc Pherson


Map No. KANSAS Sec. 23 Twp. 19 R. 2^W

Well No. 3 N. N. Russell Farm

Helmerich & Payne Company

NORTH

2

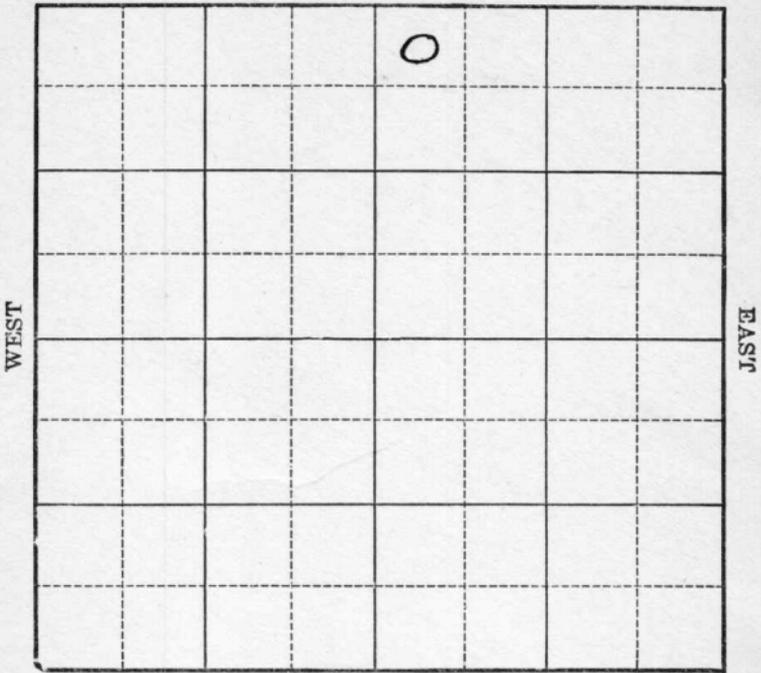

SOUTH

Location _____
Drilling Remarks _____

Rig Up _____
Drilling Remarks _____

RECORD

PRODUCTION

Cased _____ in. _____ ft.

1st 24 hrs. Nat. _____

Sand _____

1st 24 hrs. after shot _____

Gas _____

Gas _____ cu. ft.

Oil _____

Dry Hole _____

Total Depth _____

Abandoned _____

Mc Pherson

Map No. **KANSAS** Sec. 23 Twp. 19 R. 2 N

Well No. 3-77-71 Russell Farm


Helmick & Payne Company

330 Ft. from N. Line

_____ Ft. from S. Line

_____ Ft. from E. Line

330 Ft. from W. Line

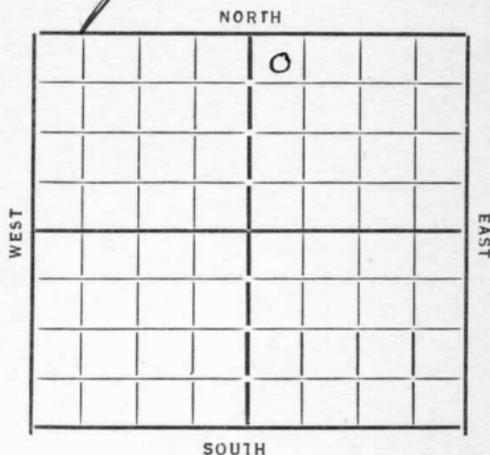

1934

REPORT

1/31 Cellar
 2/7 Rigging Rotary
 2/14 Dily 1255
 2/23 " 2920
 3/1 " 3285 Chat 2885
 3/8 Viola 3352 75 Cem.
 7" 3351
 3/15 Rust
 3/22 3356 TD 1000 Gal acid W.O.F.
 3/29 Pump 20 Bbls per hr.
 4/5 May acidize
 4/11 Viola 3352 TD 3356
 1000 Gal acid 427 Bbls.

COMPLETED

Map No. 43 Sec. 23 Twp. 19 R. 2W

Well No. 3-n.w. Russell

Helmick + Payne Company

Contractor

FIRST REPORTS


330 Ft. from N. Line

..... Ft. from S. Line

..... Ft. from E. Line

330 Ft. from W. Line

SECTION PLAT

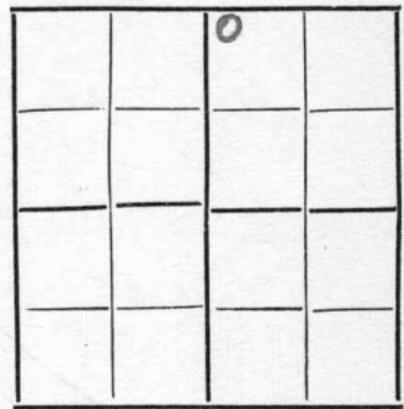

Location.....

Rig up.....

Drilling and Remarks:

cellar

RECORD

Cased.....in.,ft.

Sand.....

Gas.....

Oil.....

Total Depth.....

PRODUCTION

1st 24 hrs. Nat.....

1st 24 hrs. after shot.....

Gas.....Cu. Ft.

Dry Hole.....

Abandoned.....

Date

1-31-34 192..... O. Mannedick Scout

Mephuson
Map No. 43 Sec. 23 Twp. 19 R. 24

Well No. 3-71. W. Russell

Helmerick & Payne Company

Contractor

COMPLETED

SECTION PLAT

330 Ft. from N. Line
..... Ft. from S. Line
..... Ft. from E. Line
330 Ft. from W. Line

		0	

Location.....

Rig up.....

Drilling and Remarks:

1000 gal acid

427 bbls

RECORD

Cased.....in.,ft.

Sand *Viola 3357*

Gas.....

Oil.....

Total Depth 3356

PRODUCTION

1st 24 hrs. Nat.....

1st 24 hrs. after shot.....

Gas.....Cu. Ft.

Dry Hole.....

Abandoned.....

Date

4-11-34 192 O. M. Mannschreck Scout