


Section 23 Township 19 Range 13-W

Well No. #1 Hill

Company Alpine Oil & Royalty

6

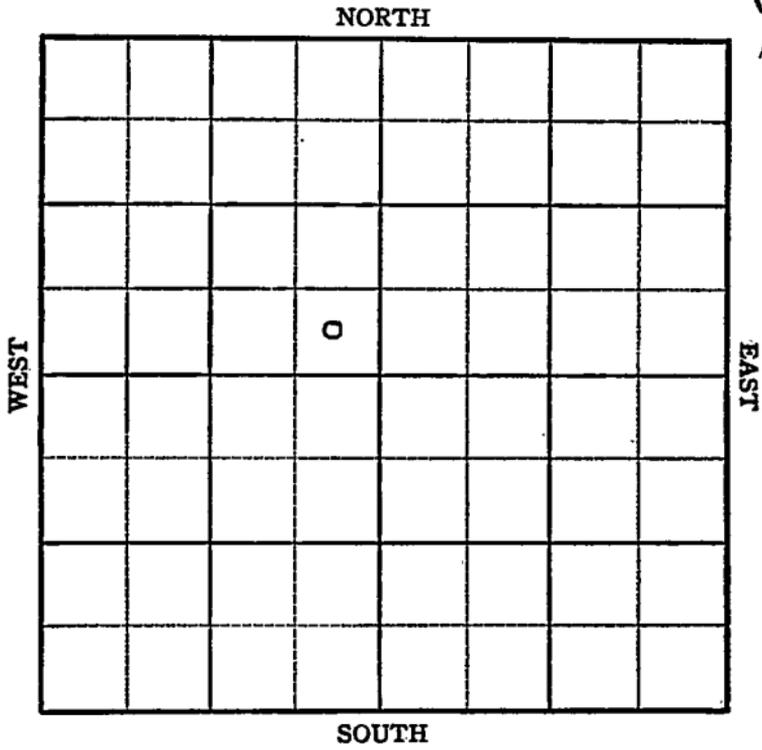

Sec. 23 Twp. 19 R. 13W ✓

Well No. #1 Hill Farm

Alpine Oil & Royalty Company

Contractor


Wildcat  
Ft. from N. Line

330'  
Ft. from S. Line

330'  
Ft. from E. Line

Ft. from W. Line

SE SE NW

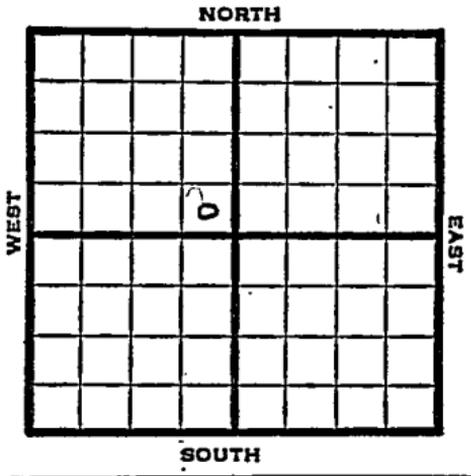

1950 Elev. 1839' REPORT

5/17 Spud 5-14-50  
8" @ 347'  
WOC

5/31 8" @ 347'  
Heeb 3057'  
Br. Lime 3168'  
Lans. 3179'  
Arb. 3430-60  
TD 3460'  
D&A

**ABANDONED**

Map No. \_\_\_\_\_ Sec. 23 Twp. 19 R. 13WWell No. 1 HillAlpine Oil & Royalty Company\_\_\_\_\_  
Contractor

SE SE NW

## SECTION PLAT

\_\_\_\_\_ Ft. from N. Line

330 Ft. from S. Line330 Ft. from E. Line

\_\_\_\_\_ Ft. from W. Line

		o	
		FIRST REPORT	

Barton

Location \_\_\_\_\_

Rig up \_\_\_\_\_

Drilling and Remarks:

Spud. 5-14-50

8" @ 347'

W. O. C.

## RECORD

Cased \_\_\_\_\_ in., \_\_\_\_\_ ft.

Sand \_\_\_\_\_

Gas \_\_\_\_\_

Oil \_\_\_\_\_

Total Depth \_\_\_\_\_

## PRODUCTION

1st 24 hrs. Nat. \_\_\_\_\_

1st 24 hrs. after shot \_\_\_\_\_

Gas \_\_\_\_\_ Cu. Ft.

Dry Hole \_\_\_\_\_

Abandoned \_\_\_\_\_

Date

MAY 17 1950

19

J. E. TYRA

Scout

Wildcat

Form 26 200 Bks. 11-49 Petrol

Kansas

Map No. \_\_\_\_\_ Sec. 23 \_\_\_\_\_ Twp. 19 \_\_\_\_\_ R. 13W \_\_\_\_\_

Well No. 1 Hill \_\_\_\_\_

Alpine Oil & Royalty \_\_\_\_\_ Company

Contractor

SE SE NW

E 1. 1839  
SECTION PLAT

\_\_\_\_\_ Ft. from N. Line

330 Ft. from S. Line

330 Ft. from E. Line

\_\_\_\_\_ Ft. from W. Line

	0		

ABANDONED

Barton

Location \_\_\_\_\_

Rig up \_\_\_\_\_

Drilling and Remarks:

8" c. 347  
Neub. 3057  
Br. line 3168  
Lans. 3179  
arb. 3430-60  
D+A

RECORD

Cased \_\_\_\_\_ in., \_\_\_\_\_ ft.

Sand \_\_\_\_\_

Gas \_\_\_\_\_

Oil \_\_\_\_\_

Total Depth 3460

PRODUCTION

1st 24 hrs. Nat. \_\_\_\_\_

1st 24 hrs. after shot \_\_\_\_\_

Gas \_\_\_\_\_ Cu. Ft.

Dry Hole \_\_\_\_\_

Abandoned \_\_\_\_\_

Date

MAY 31 1950 19

J. E. TYRA Scout