


Section 23 Township 19 Range 17W

Well No. 1 Bortz

Company H. H. & B. Drilling Co.

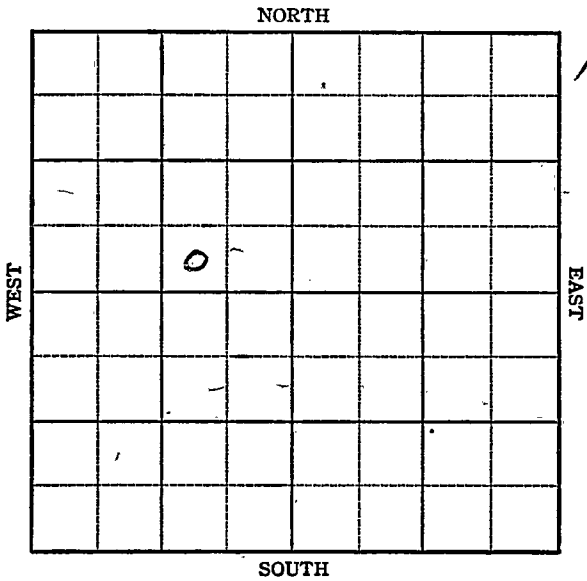

Rush

KANSAS ✓

Sec. 23 Twp. 19 R. 17W

Well No. #1 Bortz Farm

H. H. & B. Drlg. et al Company
Wildcat


 Ft. from N. Line

330 Ft. from S. Line

990 Ft. from E. Line

 Ft. from W. Line

SW SE NW

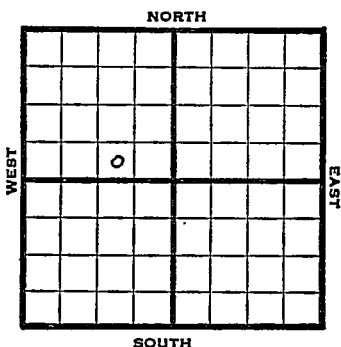

1947

Elev. 2109' REPORT

5/21 Location.

5/27 Drlg. 660'

6/3 8" @ 1198
Drlg 2705'

6/10 Lansing 3516'
Conglomerate 3830'
Drlg. 3855'

6/18 Arb. 3862'
TD 3950'

ABANDONED

Map No. K81 Sec. 23 Twp. 19 R. 17W

Well No. 1 Bortz

H. H. & B. Drlg. etal. Company

FIRST REPORT Contractor

SW SE NW


SECTION PLAT

 Ft. from N. Line

330 Ft. from S. Line

990 Ft. from E. Line

 Ft. from W. Line

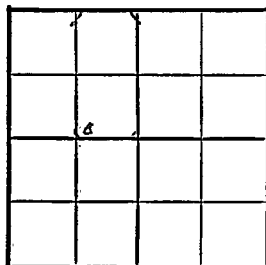

Rush County

Location X

Rig up

Drilling and Remarks:

RECORD

Cased in, ft.

Sand

Gas

Oil

Total Depth

PRODUCTION

1st 24 hrs. Nat.

1st 24 hrs. after shot

Gas Cu. Ft.

Dry Hole

Abandoned

Date

MAY 21 1947 19 S. J. LEWIS Scout

Kansas

Map No. 81 Sec. 23 Twp. 19 R. 17WWell No. 1 BortzH. H. & B. Drlg. etal. Company**ABANDONED**

Contractor

E. J. 109.

SW SE NW

SECTION PLAT

	△		

 Ft. from N. Line330 Ft. from S. Line990 Ft. from E. Line Ft. from W. LineRush CountyLocation Rig up

Drilling and Remarks:

CR 3862

RECORD

Cased in., ft.Sand Gas Oil Total Depth 8958

PRODUCTION

1st 24 hrs. Nat. 1st 24 hrs. after shot Gas Cu. Ft.Dry Hole Abandoned

Date

JUN 1 8 194719S. J. LEWIS Scout