


Barton

Section 23 Township 19 Range 15-W

Well No. 1 Gagleman

Company Amerada

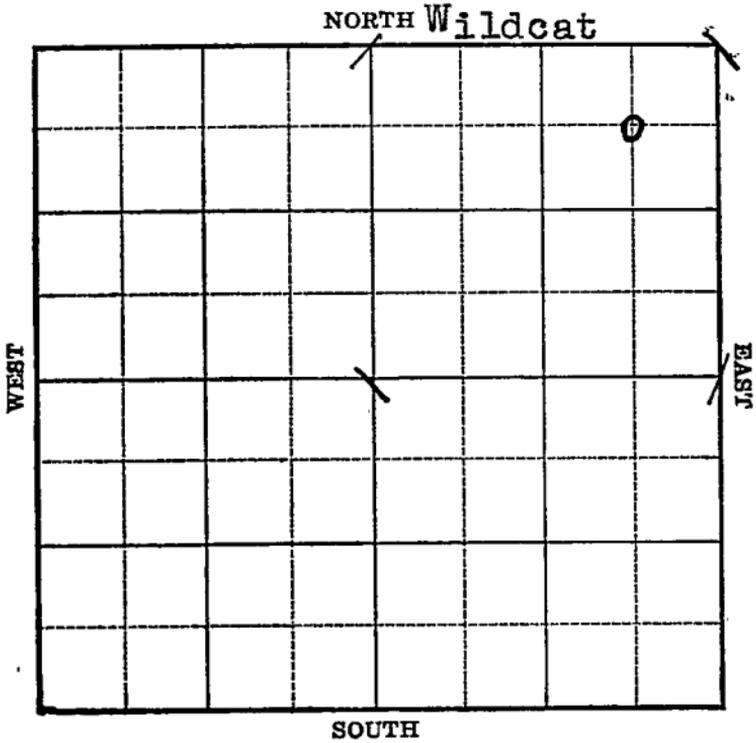

Sec. 23 Twp. 19 R. 15-W

Well No. #1 Gagleman Farm

Amerada

Company

(Wildcat)


66.0 Ft. from N. Line

_____ Ft. from S. Line

660 Ft. from E. Line

_____ Ft. from W. Line

Elev. 1918

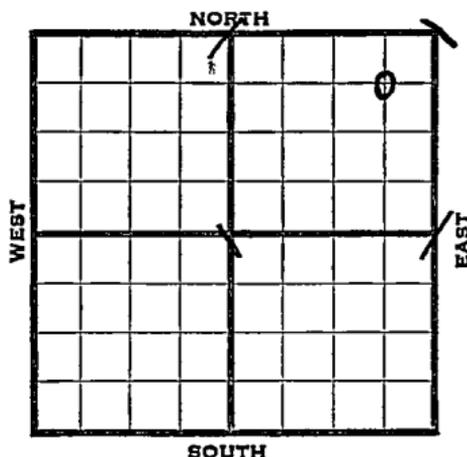

1939	REPORT
4/19	Cellar.
4/28	16" - 40' WOC.
5/5	10" - 544' cemented. Anhy 846'
5/12	Drlg. 2900'
5/19	Ft. Riley 1900' Base Florence Flint 2040'
	Lans. 3238' S. O. 3253-57'
	T.D. 3356' Fsg. drill pipe.
5/26	Fishing job cleaned up. getting ready to drill ahead.
5/31	Cong. 3502'
	Song. sand 3505'
	S. O. 3505-09'
	No Arbuckle.
	T.D. 3578'
ABANDONED	

Barton

KANSAS

Map No. 82 Sec. 23 Twp. 19 R. 15WWell No. 1 GaglemanAmerada

Company

Contractor

FIRST REPORT

C NE NE

660 Ft. from N. Line Ft. from S. Line660 Ft. from E. Line Ft. from W. Line

SECTION PLAT

			0

WILD CAT

Location Rig up

Drilling and Remarks:

CELLAR

RECORD

Cased in., ft.Sand Gas Oil Total Depth

PRODUCTION

1st 24 hrs. Nat. 1st 24 hrs. after shot Gas Cu. Ft.Dry Hole Abandoned

Date

APR 19 1939 19H. D. Hatfield Scout

Barton

Map No. 82 Sec. 23 Twp. 19 R. 15W

Well No. 1 Gagleman

Amerada Company

Contractor

ABANDONED

C NE NE


SECTION PLAT

660 Ft. from N. Line

_____ Ft. from S. Line

660 Ft. from E. Line

_____ Ft. from W. Line

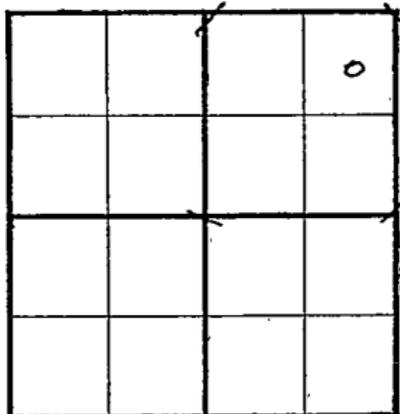

WILDCAT

Location _____

Rig up _____

Drilling and Remarks:

Cong 3502
Cong Sol. 3505
80 3505 -09.
No gas buckle

RECORD

Cased _____ in., _____ ft.

Sand _____

Gas _____

Oil _____

Total Depth 3578

PRODUCTION

1st 24 hrs. Nat. _____

1st 24 hrs. after shot _____

Gas _____ Cu. Ft.

Dry Hole _____

Abandoned _____

Date

MAY 31 1939 19

S. J. LEWIS

Scout