

KANSAS


Barton

FORM 51 5M 1-42 PETROL

Section 24 Township 19 Range 11-W

Well No. #3
~~#2~~ Herr "A"

Company Vickers

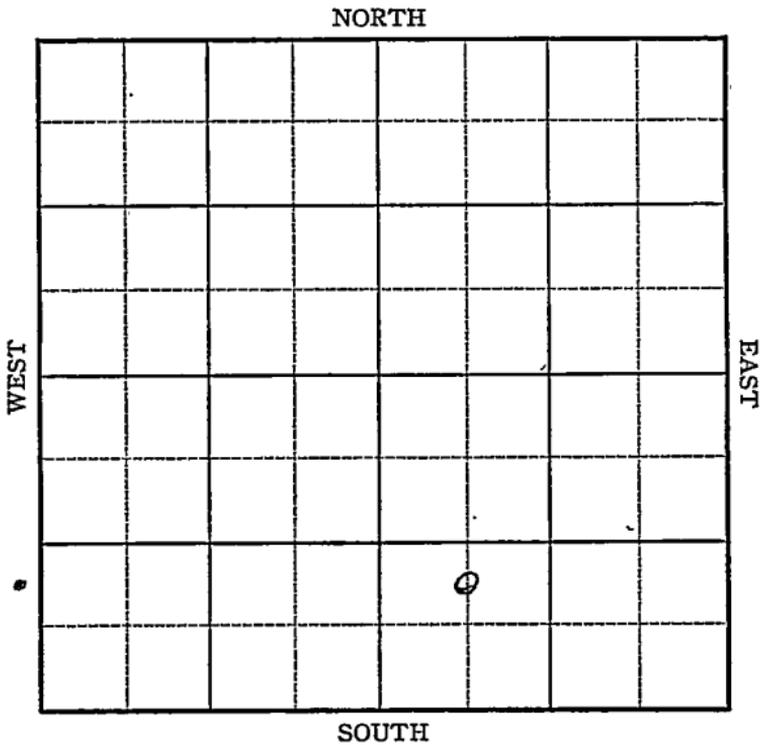

Sec. 24 Twp. 19 R. 11-W

Well No. ~~#3~~ #2 Herr "A" Farm

Vickers Company


Silica

_____ Ft. from N. Line

990 Ft. from S. Line

_____ Ft. from E. Line

660 Ft. from W. Line

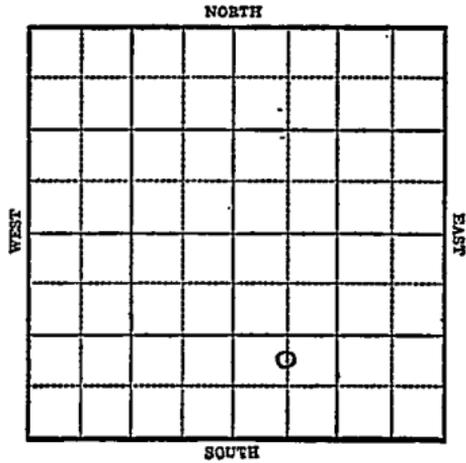

C NL SW SE

R E P O R T

1943

- 2/3 Rotary
- 2/10 10" @ 170'
Drlg. 2060'
- 2/17 Lans 3022
Arb 3322
SO 3320-21
3325-29 TD
5" Casing set 3322 RUST.
- 2/24 TD 3365 On oil or water 500
acid no help.
- 3/3 Arb. 3322
5" @ 3322'
T.D. 3365'
500 gal acid
12 qts. shot.
No shows.

ABANDONED

Barton

Map No. KANSAS Sec. 24 Twp. 19 R. 11W

Well No. 2 Herr "A"

Vickers Company

FIRST REPORT

Contractor

C NL SW SE

SECTION PLAT

_____ Ft. from N. Line

990 Ft. from S. Line

_____ Ft. from E. Line

660 Ft. from W. Line

| | | | |
|--|--|---|--|
| | | | |
| | | | |
| | | | |
| | | o | |

SILICA POOL

Location _____

Rig up _____

Drilling and Remarks:

Rotary

RECORD

Cased _____ in., _____ ft.

Sand _____

Gas _____

Oil _____

Total Depth _____

PRODUCTION

1st 24 hrs. Nat. _____

1st 24 hrs. after shot _____

Gas _____ Cu. Ft.

Dry Hole _____

Abandoned _____

Date

FEB 3 1943 19

S. J. LEWIS Scout

KANSAS

Map No. 46 Sec. 24 Twp. 19 R. 11WWell No. 3 Herr "A"

Vickers

Company

ABANDONED

Contractor

C NL SW SE

SECTION PLAT

| | | | |
|--|--|---|--|
| | | | |
| | | | |
| | | | |
| | | 6 | |

_____ Ft. from N. Line

990 Ft. from S. Line

_____ Ft. from E. Line

660 Ft. from W. Line

SILICA POOL

Location _____

Rig up _____

Drilling and Remarks:

*Cr 8322**5" @ 8322**500 cu ft**127 shot**No horse*

RECORD

Cased _____ in., _____ ft.

Sand _____

Gas _____

Oil _____

Total Depth 2365

PRODUCTION

1st 24 hrs. Nat. _____

1st 24 hrs. after shot _____

Gas _____ Cu. Ft.

Dry Hole _____

Abandoned _____

Date

MAR 3 1943 19

S. I. LEWIS Scout