


Section 24 Township 19 Range 11-W

Well No. #1 Herr Est. "C"

Company Vickers  
Eberhardt pool

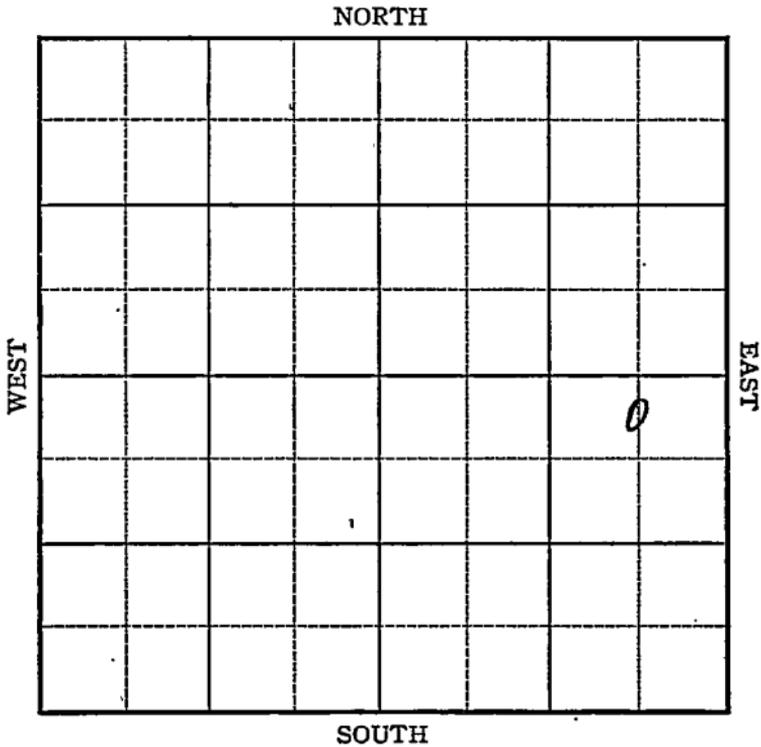

Sec. 24 Twp. 19 R. 11-W

Well No. #1 Herr Est. "C" Farm

Vickers Company

(Eberhardt)


330 Ft. from N. Line

\_\_\_\_\_ Ft. from S. Line

660 Ft. from E. Line

\_\_\_\_\_ Ft. from W. Line

Elev. 1769

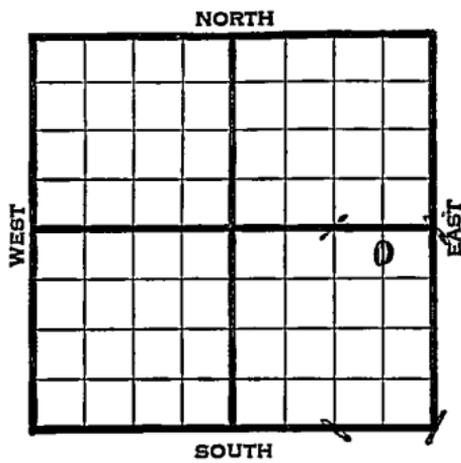

1941	REPORT
10/15	S. H.
10/23	10" - 183' Drlg. 2400'
10/30	Lans. 3006' Arb. 3351-65' T.D. 5" - 3365' RUST.
11/6	P.B. to 3357'
	23 shots 3094-3105'
	Flow 5 oil per hour.
11/13	Swab 89 oil & 18 water in 8 hours.
11/19	Arb. 3351'
	5" - 3365'
	T.D. 3365'
	P.B. to 3357'
	23 shots 3094-3105'
	2000 acid.
	Depthograph potential 3000 bbls.
	41. Gravity
	<b>COMPLETED</b>

Map No. K-46 Sec. 24 Twp. 19 R. 11W

Well No. 1 Herr Est. "C"


Vickers Company

FIRST REPORT Contractor

C NL NE SE

**SECTION PLAT**

330 Ft. from N. Line

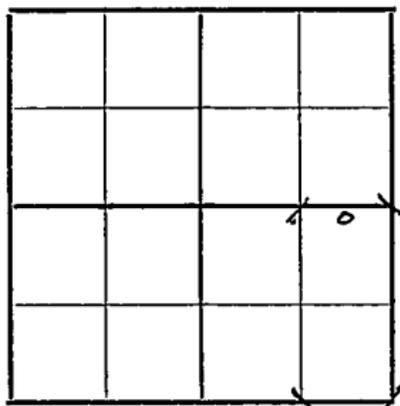

\_\_\_\_\_ Ft. from S. Line

660 Ft. from E. Line

\_\_\_\_\_ Ft. from W. Line

**EBERHARDT POOL**

Location \_\_\_\_\_

**RECORD**

Rig up \_\_\_\_\_

Drilling and Remarks:

Cased \_\_\_\_\_ in., \_\_\_\_\_ ft.

Sand \_\_\_\_\_

Gas \_\_\_\_\_

Oil \_\_\_\_\_

Total Depth \_\_\_\_\_

S.H.

**PRODUCTION**

1st 24 hrs. Nat. \_\_\_\_\_

1st 24 hrs. after shot \_\_\_\_\_

Gas \_\_\_\_\_ Cu. Ft.

Dry Hole \_\_\_\_\_

Abandoned \_\_\_\_\_

Date

**S. J. LEWIS**

OCT 15 1941 19

Scout

Barton **KANSAS**Map No. K46 Sec. 24 Twp. 19 R. 11WWell No. 1 Herr Est. "C"Vickers Company**COMPLETED** Contractor

C N L N E S E

## SECTION PLAT

330 Ft. from N. Line

\_\_\_\_\_ Ft. from S. Line

660 Ft. from E. Line

\_\_\_\_\_ Ft. from W. Line

			o

EBEHARDT P OOL

## RECORD

Location \_\_\_\_\_

Cased \_\_\_\_\_ in., \_\_\_\_\_ ft.

Rig up \_\_\_\_\_

Sand \_\_\_\_\_

Drilling and Remarks:

Gas \_\_\_\_\_

Oil \_\_\_\_\_

Total Depth 3365

\_\_\_\_\_

## PRODUCTION

1st 24 hrs. Nat. \_\_\_\_\_

1st 24 hrs. after shot \_\_\_\_\_

Gas \_\_\_\_\_ Cu. Ft.

Dry Hole \_\_\_\_\_

Abandoned \_\_\_\_\_

Date

NOV 19 1941

19

S. J. LEWIS

Scout