


Section 24 Township 19 Range 11W

Well No. # 3 Herr "A"

Company Vickers

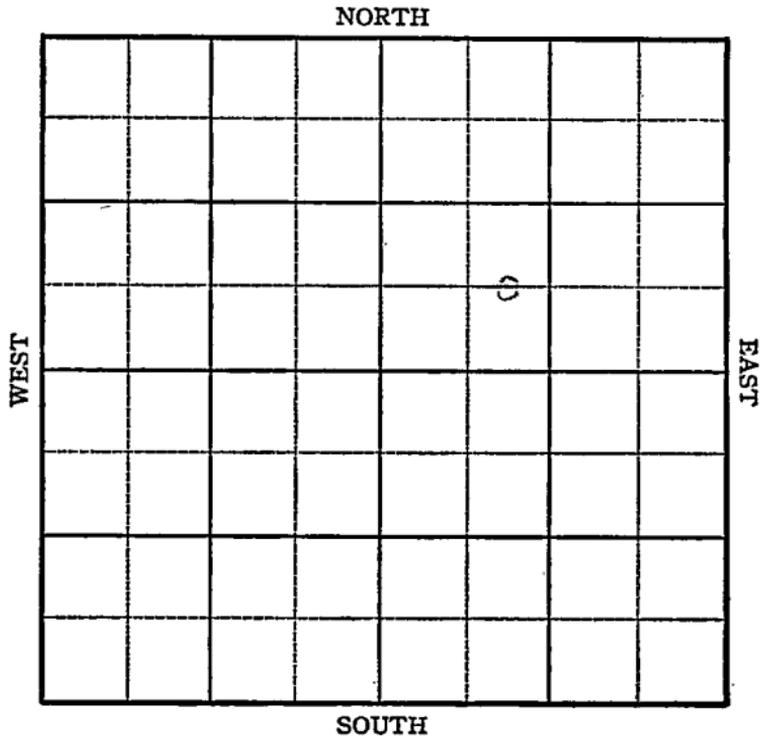

Sec. 24 Twp. 19 R. 11-W

Well No. #4 ~~#3~~ Herr "A" Farm


Vickers Company

Ft. from N. Line

660 Ft. from S. Line

Ft. from E. Line

990 Ft. from W. Line

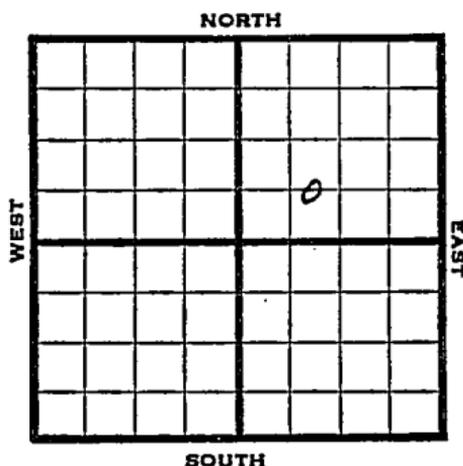

C E L SW NE

1945 Elev. 1769 REPORT

11/14 Location
 11/21 "
 11/28 10" @ 173 WOC
 12/5 Drilg. 2950
 12/12 Lans 3009
 Arb. 3294
 TD 3297
 5" @ 3294 RUST
 12/20 T.D. 3298' 1750' oil 11 hours.
 12/29 2000 acid. No test.

1946

1/9 Arb. 3294
 5" @ 3294
 2000 acid.
 TD 3298
 Echo Pot. 1535
 Grav. 41.6

COMPLETED

KANSAS Kansas Pool Name SilicaMap No. 46 Sec. 24 Twp. 19 R. 11WWell No. 3 Herr "A"Vickers CompanyFIRST REPORT Contractor

C E L SW NE

SECTION PLAT

 Ft. from N. Line660 Ft. from S. Line Ft. from E. Line990 Ft. from W. LineBarton CountyLocation XRig up

Drilling and Remarks:

RECORD

Cased in., ft.Sand Gas Oil Total Depth

PRODUCTION

1st 24 hrs. Nat. 1st 24 hrs. after shot Gas Cu. Ft.Dry Hole Abandoned

Date

NOV 14 1945 19S. J. LEWIS Scout

Kansas Pool Name SilicaMap No. 46 Sec. 24 Twp. 19 R. 11WWell No. 4 Herr "A"Vickers

Company

CORRECTION

Contractor

C E L SW NE

SECTION PLAT

 Ft. from N. Line660 Ft. from S. Line Ft. from E. Line990 Ft. from W. Line

Barton County

Location Rig up

Drilling and Remarks:

Reported

#3 Herr "A"

RECORD

Cased in., ft.Sand Gas Oil Total Depth

PRODUCTION

1st 24 hrs. Nat. 1st 24 hrs. after shot Gas Cu. Ft.Dry Hole Abandoned

Date

NOV 21 1945 19S. J. LEWIS

Scout

Kansas Pool Name Silica

KANSAS
 Map No. 46 Sec. 24 Twp. 19 R. 11W

Well No. 4 Herr "A"

Vickers Company

COMPLETED

Contractor

C E L S W N E

E 11767
SECTION PLAT

 Ft. from N. Line

660 Ft. from S. Line

 Ft. from E. Line

990 Ft. from W. Line

		o	

Barton County

Location

Rig up

Drilling and Remarks:

Cor 3294
5" @ 3294
2000' acid
Echo Pt 1500

H 1/2 SW

RECORD

Cased in., ft.

Sand

Gas

Oil

Total Depth 3294

PRODUCTION

1st 24 hrs. Nat.

1st 24 hrs. after shot

Gas Cu. Ft.

Dry Hole

Abandoned

Date

JAN 9 1946

19

S. J. LEWIS

Scout