


Section 24 Township 19 Range 11-W

Well No. #5 Herr "A"

Company Vickers

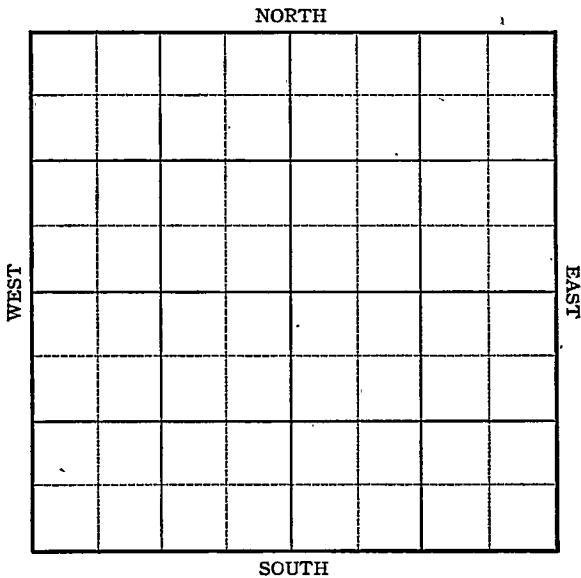

Sec. 24 Twp. 19 R. 11W

Well No. #5 Herr "A" Farm _____

Vickers Company _____

Silica


330 Ft. from N. Line

_____ Ft. from S. Line

440 Ft. from E. Line

~~990~~ Ft. from W. Line

NW NE NW

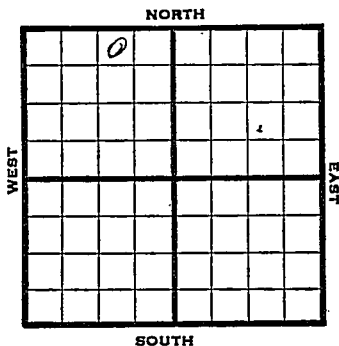

1945

REPORT

Elev. 1777

12/19

Location

12/29

Drlg. 2410'

1946

1/10

10" - 159' Lans. 3043'

Arb. 3336' 5" - 3343'

Drlg. 3354'

1/16

Arb. 3336

5" @ 3343

TD 3388'

ABANDONED

KANSAS Kansas Pool Name SilicaMap No. K-46 Sec. 24 Twp. 19 R. 11WWell No. 5 Werr "A"Vickers CompanyFIRST Contractor

N. NE NW

330 ^{OK} Ft. from N. Line

Ft. from S. Line

990 Ft. from E. Line~~990~~ Ft. from W. Line

SECTION PLAT

	0'		

Barton County

Location Rig up

Drilling and Remarks:

RECORD

Cased in., ft.Sand Gas Oil Total Depth

PRODUCTION

1st 24 hrs. Nat. 1st 24 hrs. after shot Gas Cu. Ft.Dry Hole Abandoned

Date

DEC 19 1945

19

S. J. LEWIS Scout

KANSAS

Kansas

Pool Name Silica

Map No. 46 Sec. 24 Twp. 19 R. 11W.

Well No. 5 Herr "A"

Vickers

Company

ABANDONED

Contractor

NW NE NW

E. 1777
SECTION PLAT

330 Ft. from N. Line

Ft. from S. Line

990 Ft. from E. Line

~~990~~ Ft. from W. Line

	o		

Barton County

RECORD

Location _____

Cased _____ in., _____ ft.

Rig up _____

Sand _____

Drilling and Remarks:

Gas _____

Oil _____

Total Depth 288

Ord 3336
508843

PRODUCTION

1st 24 hrs. Nat. _____

1st 24 hrs. after shot _____

Gas _____ Cu. Ft.

Dry Hole _____

Abandoned _____

Date

JAN 16 1946 19

S. I. LEWIS

Scout