


FORM 51 5M 4-41 PETROL **Barton**

KANSAS

Section 24 Township 19 Range 11W


Well No. 2 Herr Est.

Company Vickers

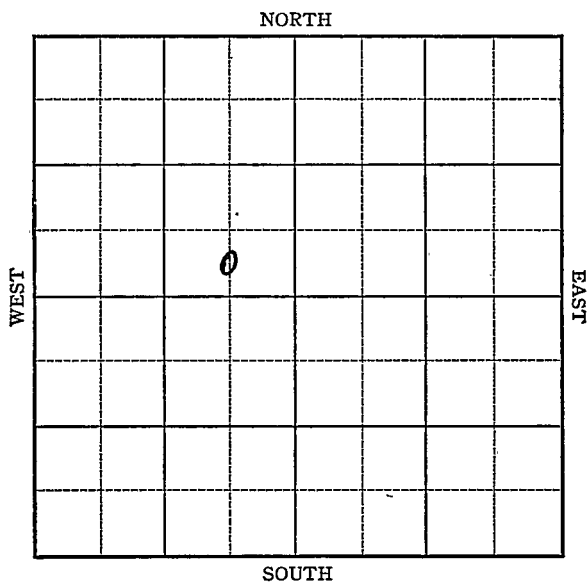

Sec. 24 Twp. 19 R. 11-WWell No. #2 Herr Est. FarmVickers Company
(Wildcat)120 Ft. from N. Line330 Ft. from S. Line660 Ft. from E. Line Ft. from W. Line

Elev. 1774

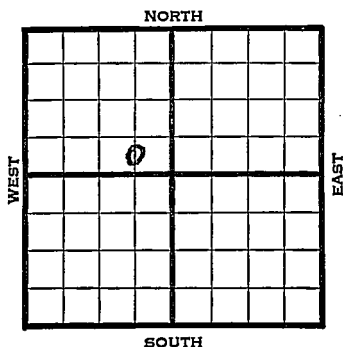

1941

REPORT

6/16

Rotary.

6/26

10" - 181' Drlg. 27 50'

7/1

Lens. 3016'

Cong. 3320'

T.D. 3397'

No shows.

ABANDONED

Map No. 46 Sec. 24 Twp. 19 R. 11WWell No. 2 Herr Est.Vickers


Company

FIRST REPORT

Contractor

SECTION PLAT

C S L SE NW

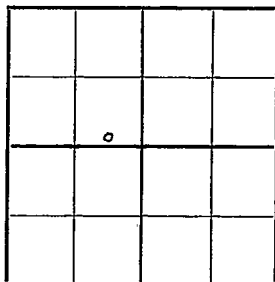 Ft. from N. Line330 Ft. from S. Line660 Ft. from E. Line Ft. from W. Line

WILDCAT

Location Rig up

Drilling and Remarks:

Rotary

RECORD

Cased in., ft.Sand Gas Oil Total Depth

PRODUCTION

1st 24 hrs. Nat. 1st 24 hrs. after shot Gas Cu. Ft.Dry Hole Abandoned

Date

JUN 18 194119S. I. LEWIS Scout

Map No. 46 Sec. 24 Twp. 19 R. 11WWell No. 2 Herr EstateVickers

Company

ABANDONED

Contractor

C S L SE NW

SECTION PLAT

Ft. from N. Line

330 Ft. from S. Line660 Ft. from E. Line

Ft. from W. Line

EBERHART POOL

RECORD

Location _____

Cased _____ in., _____ ft.

Rig up _____

Sand _____

Drilling and Remarks:

Gas _____

Oil _____

Total Depth 3327

PRODUCTION

1st 24 hrs. Nat. _____

1st 24 hrs. after shot _____

Gas _____ Cu. Ft.

Dry Hole _____

Abandoned _____

Date

JUL 1 1941

19

S. J. LEWIS

Scout