

O.W.P.B.

KANSAS


Barton

FORM 51 (MAY 41) PETROL 1

Section 24 Township 19 Range 11-W


Well No. #1 Herr Est. "B"

Company Vickers

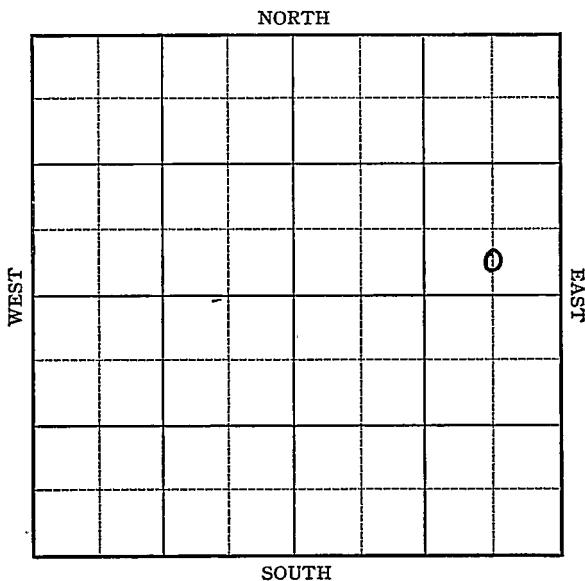

Sec. 24 Twp. 19 R. 11-WWell No. #1 Herr Est. "B" FarmVickers Company~~(Eberhardt)~~ Chase-Silica Pool Ft. from N. Line330 Ft. from S. Line660 Ft. from E. Line Ft. from W. LineC S/2 SE NE

Elev. 1768

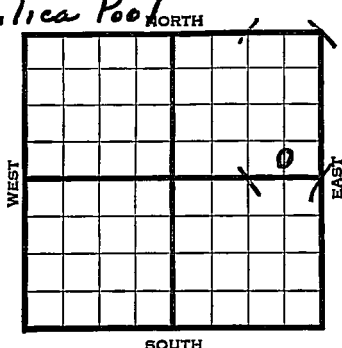

1941

REPORT

9/24 Derrick.

10/2 Drlg. 800'

10/9 Drlg. 1500'

10/16 Lans. 2996' Arb. 3291'

T.D. 3298' 5" - 3292' RUST.

10/22 Arb. 3291'

5" - 3292'

T.D. 3298'

2000 acid.

Depthograph potential 3244 bbls.

Maximum 3000 bbls.

41. Gravity

COMPLETED

1953

O. W. P. B.

5/6 KC 2996' Arb. 3291' OTD 3298'

5" @ 3291 To PB & test KC

5/21 NR

5/28 "

OVER

1953

7/1

Oil well TD 3298 KC 2996

Arb. 3291 OTD 3298 5" @ 3291

PB 3240 24/3186-90 46/3086-94

2000 A P/6 BOPH 12% wtr.

Comp. 50 BOPD 12% wtr.


COMPLETED

Map No. K-46 Sec. 24 Twp. 19 R. 11WWell No. 1 Herr Est. "B"Vickers CompanyFIRST REPORT Contractor

C SL SE NE

 Ft. from N. Line330 Ft. from S. Line660 Ft. from E. Line Ft. from W. Line

SECTION PLAT

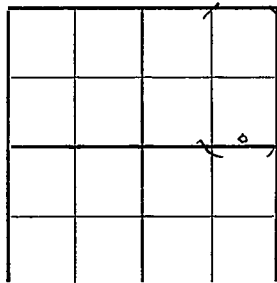

Ebēhardt Pool

Location Rig up

Drilling and Remarks:

Derrick

RECORD

Cased in., ft.Sand Gas Oil Total Depth

PRODUCTION

1st 24 hrs. Nat. 1st 24 hrs. after shot Gas Cu. Ft.Dry Hole Abandoned

Date

SEP 24 194119S. J. LEWISScout

Misc. Small Maps

Cards

Tracing

France Map

Scarborough Map

Moody Map

Geological Dept.

Moody Plat Book

Barton

KANSAS

Map No. 11-46 Sec. 24 Twp. 19 R. 11WWell No. 1 Herr Est. "B"Vickers CompanyCOMPLETED Contractor

C SL SE NE

 Ft. from N. Line330 Ft. from S. Line660 Ft. from E. Line Ft. from W. Line

SECTION PLAT

			o

EBEHARDT POOL

Location Rig up

Drilling and Remarks:

Cor & 3291
 5" @ 3292
 2000' acid
 Depth 3244 ft.
 Max 8000
 412 ft

RECORD

Cased in., ft.Sand Gas Oil Total Depth 3298

PRODUCTION

1st 24 hrs. Nat. 1st 24 hrs. after shot Gas Cu. Ft.Dry Hole Abandoned

Date

OCT 22 1941 19S. J. LEWIS Scout

Misc. Small Maps

Cards

Tracing

France Map

Scarborough Map


Moody Map

Geological Dept.

Moody Plat Book

O. W. P. B.

County Barton State Kansas
 Sec. 24 (Blk.) 19 (Sur.) 11W Map No.
 Operator Vickers Pet.
 Well No. 1 Farm Herr "B"
 Elev. 1768 Location C S $\frac{1}{2}$ SE NE

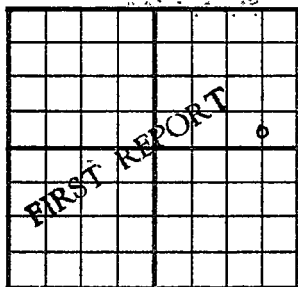

330 Ft. From S Line NE
660 Ft. From E Line Quarter
 Ist. Report MAY 6 1953

Completion

Remarks

OWPB

O. W. P. B.

Spudding Date

Drlg. Data

Chase-Silica Pool

KC 2996 Arb. 3291 OTD 3298 5" @ 3291
to PB & test KC


J. G. McGEHEE

MAY 8 1953

Scout Cards	_____
Land Small Map	_____
Land Wall Map	_____
Tracings	_____
Fence Map	_____
Plants Map	_____
Misc.	_____

Orig. Data

O. W. P. B.

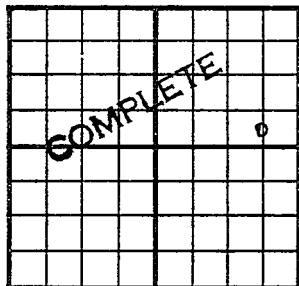County Barton State KansasSec. 24 (Blk.
Twp.) 19 (Sur.
Rge.) 11W Map No.Operator Vickers Pet.Well No. 1 Farm Herr "B"Elev. 1768 Location C S $\frac{1}{2}$ SE NE330Ft. From S Line NE660Ft. From E Line Quarter

1st. Report

Completion JUL 1 1953Remarks OWPB

O. W. P. B.

Spudding Date

Drilg. Data Oil well TD 3298KC 2996 Arb. 3291 OTD 3298 5" @ 3291PB 3240 24/ 3186-90 46/ 3086-942000 A P/ 6 boph 12% wtr.Comp. 50 bopd 12% wtr.

J. G. MCGEEHEE

Scout Cards	mm
Land Small Map	
Land Wall Map	3
Tracings	
France Map	
Pierce Map	
Misc	

Jul 6 1953

Orig. Data