

Section 24 Township 19 Range 11W

Well No. 2 Roth

Company Vickers

Rick

NORTH

WEST

EAST

	0						

SOUTH

KANSAS

Barton

Sec. 24 Twp. 19 R. 11W ✓

Well No. #2 Roth Farm

Vickers Company

Rick Pool

_____ Ft. from N. Line


330'

_____ Ft. from S. Line

_____ Ft. from E. Line

990' Ft. from W. Line

SE SW SW

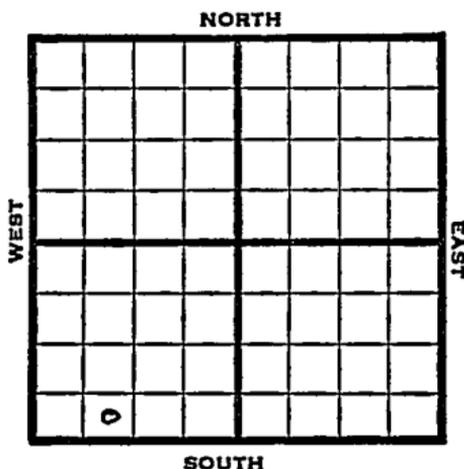

1949

Elev 1770'

R E P O R T

5/4

8" @ 199'
Drlg. 1575'

5/10

Lansing 3034'
Arb. 3353-67'
TD 3367'
5" @ 3354'

5/18

TD 3384'
Arb. 3353'
5" @ 3354'
Aband.

ABANDONED

Map No. _____ Sec. 24 Twp. 19 R. 11W

Well No. 2 Roth

Vickers Company

FIRST REPORT

Contractor

SE SW SW

SECTION PLAT

_____ Ft. from N. Line

330 Ft. from S. Line

_____ Ft. from E. Line

990 Ft. from W. Line

Barton County

RECORD

Location _____

Rig up _____

Drilling and Remarks:

8" @ 199

drlg. 1575

Cased _____ in., _____ ft.

Sand _____

Gas _____

Oil _____

Total Depth _____

PRODUCTION

1st 24 hrs. Nat. _____

1st 24 hrs. after shot _____

Gas _____ Cu. Ft.

Dry Hole _____

Abandoned _____

Date

MAY 4 1949 19

S. J. LEWIS Scout

Map No. K46 Sec. 24 Twp. 19 R. 11W

Well No. 2 Roth

Vickers Company

ABANDONED

Contractor

SE SW SW

E11770
SECTION PLAT

_____ Ft. from N. Line

330 Ft. from S. Line

_____ Ft. from E. Line

990 Ft. from W. Line

Barton County

Location _____

Rig up _____

Drilling and Remarks:

*On 83253
5" @ 3254*

RECORD

Cased _____ in., _____ ft.

Sand _____

Gas _____

Oil _____

Total Depth 3284

PRODUCTION

1st 24 hrs. Nat. _____

1st 24 hrs. after shot _____

Gas _____ Cu. Ft.

Dry Hole _____

Abandoned _____

Date

MAY 18 1949 19

S. J. LEWIS Scout