
FORM 51 25M 8-50 WESTERN

Barton KANSAS

Section 24 Township 19 Range 12W

Well No. #1 E. Robl

Company W. L. Hartman

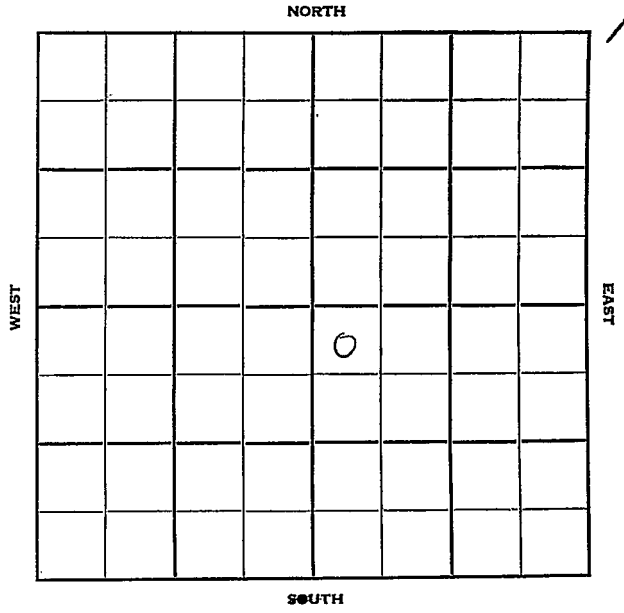

FORM 252-B
10M 10-50 PETROL

KANSAS

Barton

Sec. 24 Twp. 19 R. 12W

Well No. #1 E. Robl Farm

W. L. Hartman Company

Contractor

Wildcat


330' Ft. from N. Line

Ft. from S. Line

Ft. from E. Line

330' Ft. from W. Line

NW NW SE

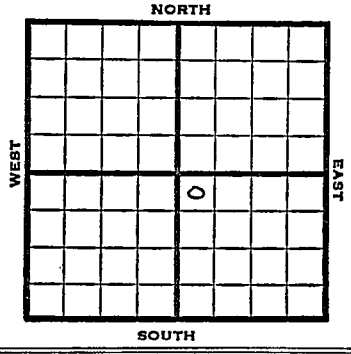

1951	Elev. 1805' REPORT
1/24	Spud 1-20-51 8" @ 186' Anhy 605-30 Drlg. 1558'
4/18	Spud 1-20-51 Oil well TD 3413' 8" @ 186' Anhy 605-30 Top 2698' Br lime 3076', Lans 3092' DST 3094-3122' open 1 hr. rec 420' gassy muddy oil DST 3174-96 open 1 hr. rec 20' mud DST 3258-75 open ½ hr. rec 6' mud B KC 3344', Arb. 3351-56' 5" @ 3354 TD 3372' SO 24/3362-71 500 A DD 3413 P/24 BOPD SP 3349 48/3115-25 S/28 BOPD DP 3413 water sq. off Perf 3362-71 SP 3344' 2000 A FU 1100' oil, 10' water SP 3108 24/3092-3100 FU 1000' oil 10 hr. 500 A S/3 BOPH CO 3344' Comp. 190 BOPD Pay 3115-35 COMPLETED

FORM 275 FOR SALE BY KANSAS BLUE PRINT CO.


County Barton State Kansas

Sec. 24 (Blk. Twp.) 19 (Sur. Rge.) 12W Map No.

Operator W. L. Herbman

Well No. 1 Farm E. Robl

Elev. Location NW NW SE

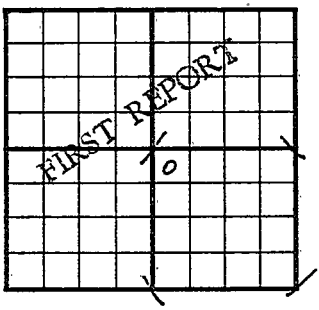

330 Ft. From N Line SE

330 Ft. From W Line Quarter

1st. Report JAN 24 1951

Completion

Remarks CSO - DHM

Spudding Date 1-20-51

Drlg. Data Wildcat

8" @ 186 Anhy 605-30 drlg. 1558

J. E. TYRA

FORM 275 FOR SALE BY KANSAS BLUE PRINT CO.


County Barton State Kansas

Sec. 24 (Blk. Twp.) 19 (Sur. Rge.) 12W Map No.

Operator W. L. Hartman

Well No. 1 Farm E. Robl

Elev. 1805 Location NW NW SE

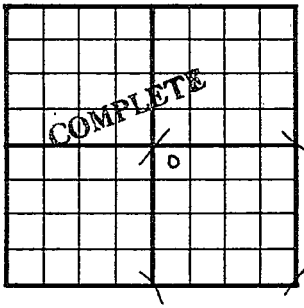

330 Ft. From N Line SE

330 Ft. From W Line Quarter

1st. Report

Completion APR 18 1951

Remarks Wildcat

Spudding Date 1-20-51

Drlg. Data Oil well TD 3413

8" @ 186 Anhy 605-30 Top. 2698

Br. lime 3076 Lans. 3092 DST 3094-3122

open 1 hr. Rec. 420' gassy muddy oil

DST 3174-96 open 1 hr. Rec. 20' mud

DST 3258-75 open ½ hr. Rec. 6' mud

B KC 3344 Arb. 3351-56 5" @ 3354

TD 3372 SO 24/ 3362-71 500 A

DD 3413 P/ 24 bopd SP 3349 48/ 3115-25

S/ 28 bopd DP 3413 ' water sq. off

Perf. 3362-71 SP 3344 2000 A

FU 1100' oil 10' water SP 3108

24/ 3092-3100 FU 1000' oil 10 hr. 500 A

S/ 3 boph CO 3344 Comp. 190 bopd

Pay 3115-35

J. E. TYRA