

KANSAS


FORM 51 5M 1-42 PETROL

Rice

Section 24 Township 19 Range 10-W

Well No. #1 Habiger "C"

Company Aylward Production

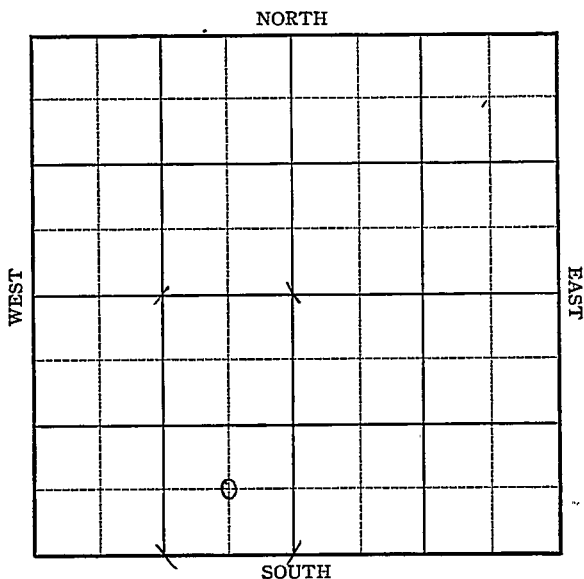

KANSAS

Rice

Sec. 24 Twp. 19 R. 10-WWell No. #1 Habiger "C" FarmAylward Production Company

Chase

Ft. from N. Line

660

Ft. from S. Line


660

Ft. from E. Line

Ft. from W. Line

C SE SW

El. 1741

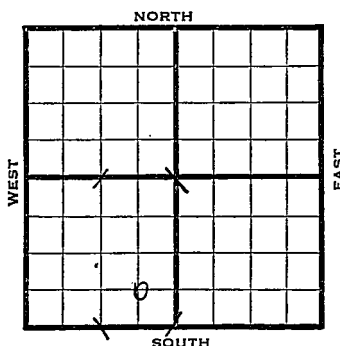

1943

REPORT

1/27	Location.
2/3	Derrick
2/10	"
2/17	8" Casing set 230 Drlg. 1550
2/24	Lans 2945 Arb 3266 Sat 3266-70 Coring 3276
3/3	Arbucklet corrected 3280 5" Casing set 3278 Rust
3/10	" " " " "
3/17	" " " " "
3/24	T.D. 295 2000 acid SO 20 Qts 3287-95 CO.
3/31	" " "
4/7	Arb 3280 5" @ 3278 Lans 2945 12 shots 3137-43 Pump 77 Pot. T.D. 3295 Grav. 43

COMPLETED

Rice

KANSAS
 Map No. Sec. 24 Twp. 19 R. 10W

Well No. 1 Habiger "C"

Aylward Production Company

FIRST REPORT Contractor

C SE SW

SECTION PLAT

 Ft. from N. Line660 Ft. from S. Line660 Ft. from E. Line Ft. from W. Line

CHASE POOL

Location XXXRig up

Drilling and Remarks:

RECORD

Cased in., ft.Sand Gas Oil Total Depth

PRODUCTION

1st 24 hrs. Nat. 1st 24 hrs. after shot Gas Cu. Ft.Dry Hole Abandoned

Date

JAN 27 1943 19 S. J. LEWIS Scout

Rice

KANSAS

Map No. 46 Sec. 24 Twp. 19 R. 10WWell No. 1 Habiger "C"Aylward Production CompanyCOMPLETED Contractor

C SE SW

SECTION PLAT

 Ft. from N. Line660 Ft. from S. Line660 Ft. from E. Line Ft. from W. Line

	0		

CHASE POOL

Location Rig up

Drilling and Remarks:

Cr 832805' @ 3278'Trans. 2945'12 1/2 hrs to 3139-43Pump 77 Po 8.4.30 Gr

RECORD

Cased in., ft.Sand Gas Oil Total Depth 3285

PRODUCTION

1st 24 hrs. Nat. 1st 24 hrs. after shot Gas Cu. Ft.Dry Hole Abandoned Date

APR 7 1943 19

S. J. LEWIS Scout