


Section 24 Township 19 Range 10W

Well No. #1, Ruhl

Company Keyes Drgl.

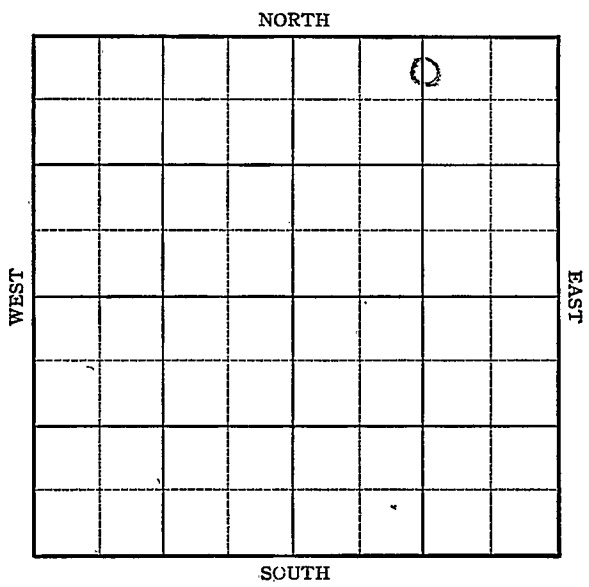

KANSAS

Rice County

Sec. 24 Twp. 19 R. 10W

Well No. #1 Ruhl Farm

Keyes Drlg. Company

Silicce


330 Ft. from N. Line

 Ft. from S. Line

1320 Ft. from E. Line

 Ft. from W. Line

CNL NE

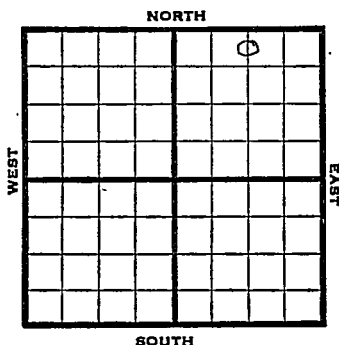

1946 Elev. 1743 REPORT

5/22 RUR

5/29 8" @ 160
Anhy. 415
Drlg. 2860'

6/5 Lans 2941
Cong 3266
TD 3290 SO
Run 5"

6/12 5" @ 3286 RUST

6/18 " " "

6/26 Pump 7 oil PH 7 hrs.

7/3 " "

7/9 " "

7/16 " "

7/23 " "

7/30 " "

8/6 " "

8/13 " "

8/21 Cong 3266

5" @ 3286

TD 3292'

Pump 99 oil plus 43% W. Pot.

Grav. 41.6

COMPLETED


KANSAS Kansas Pool Name SilicceMap No. 76 Sec. 24 Twp. 19 R. 10WWell No. 1 RuhlKeyes Drig. Company

FIRST REPORT

Contractor

C ~~M~~ L NE

SECTION PLAT

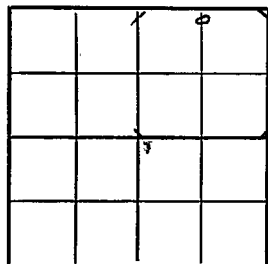330 Ft. from N. Line Ft. from S. Line1320 Ft. from E. Line Ft. from W. LineRice CountyLocation Rig up

Drilling and Remarks:

RHR

RECORD

Cased in., ft.Sand Gas Oil Total Depth

PRODUCTION

1st 24 hrs. Nat. 1st 24 hrs. after shot Gas Cu. Ft.Dry Hole Abandoned

Date

MAY 22 1946 19S. J. LEWIS

Scout

KANSAS

Kansas

Pool Name SilicaMap No. 46 Sec. 24 Twp. 19 R. 10WWell No. 1 Ruhl

Carl Lebsack

Company


COMPLETED

Contractor

C N L NE

E11743

SECTION PLAT

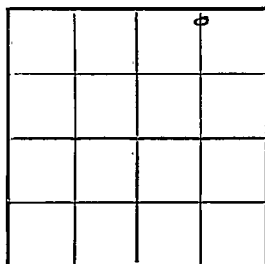330 Ft. from N. Line Ft. from S. Line1320 Ft. from E. Line Ft. from W. Line

Rice County

Location Rig up

Drilling and Remarks:

Comp 326.65" 3256Pump 29 oil +
43% W Pd41 6/8**RECORD**Cased in., ft.Sand *Gas Oil Total Depth 3292**PRODUCTION**1st 24 hrs. Nat. 1st 24 hrs. after shot Gas Cu. Ft.Dry Hole Abandoned

Date

AUG 21 1946 19S. J. LEWIS

Scout