

KANSAS

Rice

Sec. 24

Twp. 19

R. 10W

Well No. 2 Ruhl Farm

Lebsack et al Company


Silica Pool

660 Ft. from N. Line

Ft. from S. Line

330 Ft. from E. Line

Ft. from W. Line

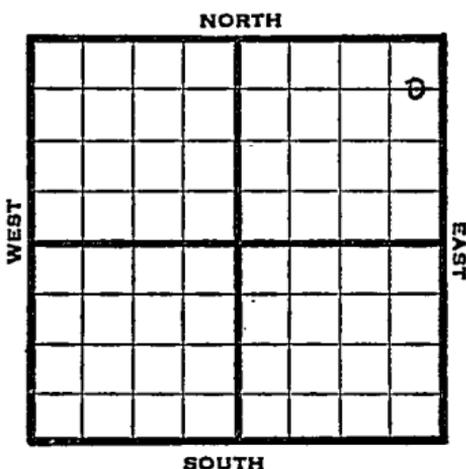

C E L N E N E

1947

Elev. 1740'

REPORT

4/30

Surface hole

5/7

8" @ 148'
Drlg. 2675'.

5/13

TD 3305'

5/21

Lans 2936
Arb 3290
TD 3302'

ABANDONED

Kansas **KANSAS**

Map No. 46 Sec. 24 Twp. 19 R. 10W

Well No. 2 Ruhl

Lebsack etal. Company

FIRST REPORT Contractor

C E L N E N E

SECTION PLAT

660 Ft. from N. Line

_____ Ft. from S. Line

330 Ft. from E. Line

_____ Ft. from W. Line

			o

Rice County

Location _____

Rig up _____

Drilling and Remarks:

surface hole

RECORD

Cased _____ in., _____ ft.

Sand _____

Gas _____

Oil _____

Total Depth _____

PRODUCTION

1st 24 hrs. Nat. _____

1st 24 hrs. after shot _____

Gas _____ Cu. Ft.

Dry Hole _____

Abandoned _____

Date

APR 30 1947 19

S. J. LEWIS Scout

Map No. 146 Sec. 24 Twp. 19 R. 10W

Well No. 2 Ruhl

Lebsack et al. Company

ABANDONED

Contractor

C E L NE NE

E 11240
SECTION PLAT

660 Ft. from N. Line

_____ Ft. from S. Line

330 Ft. from E. Line

_____ Ft. from W. Line

Rice County

Location _____

Rig up _____

Drilling and Remarks:

Leas 2286

Per 3290

RECORD

Cased _____ in., _____ ft.

Sand _____

Gas _____

Oil _____

Total Depth 3290

PRODUCTION

1st 24 hrs. Nat. _____

1st 24 hrs. after shot _____

Gas _____ Cu. Ft.

Dry Hole _____

Abandoned _____

Date

MAY 21 1947

19

S. J. LEWIS

Scout